

SCOTT

L 86 39

11-15-73

MS

E log #120

MISSISSIPPI
BOARD OF WATER COMMISSIONERS
416 North State Street
Jackson, Mississippi 39201

RECORDED

WATER WELL DRILLERS LOG

11-15

date well completed

1973 Singer Service Central Div.

firm name

Scott

county well located

LANDOWNER:
Olincraft, Inc.
Forest, Miss.
(mailing address)

description of formations encountered	from	to
<u>Brittle Clay</u>	0	25
<u>Bleed Clay</u>	25	195
<u>Clay & Sand streaks</u>	195	320
<u>Sand</u>	320	345
<u>Sandy Clay</u>	345	405
<u>Shale</u>	405	680
<u>Sand & Shale streaks</u>	680	725
<u>Sand</u>	725	798
<u>Sandy Shale</u>	798	860
<u>Shale</u>	860	920
<u>Tough lummy Shale</u>	920	996
<u>Rock</u>	996	998
<u>Tough shale - sand streaks</u>	998	1070
<u>Shale</u>	1070	1190
<u>Rock</u>	1190	1191
<u>Shale</u>	1191	1238
<u>Sand & Shale streaks</u>	1238	1320
<u>Sandy Shale</u>	1320	1355

WELL LOCATION:
sec. 18 T 6 N R 8 E
(distance) miles (direction) of (nearest town)

WELL PURPOSE:
(home, irrigation, municipal, industrial)

WELL COMPLETION DATA:

(1) diameter (inches) 10"

(2) total depth (feet) 1323'

(3) static water level (feet) 184' below top of ground.

(4) casing Steel 1260' (material) (depth)

10" if telescope see back. (size) + 62' 86"

(5) screen 50' 1260' (length) (depth to top)

6" Stainless Steel (size) (material)

(6) pump 50 300 (HP) (yield gpm)

Electric (type power)

(7) electric log yes (yes or no)

Miss. Geo. Survey (organization running log)

(8) how well bottom plugged Valve

DRILLERS REMARKS:

RECORDED


NOV 21 1973

MISS. BD. OF
WATER COM.

(V)

If well telescopes please sketch and show depths.

GROUND LEVEL

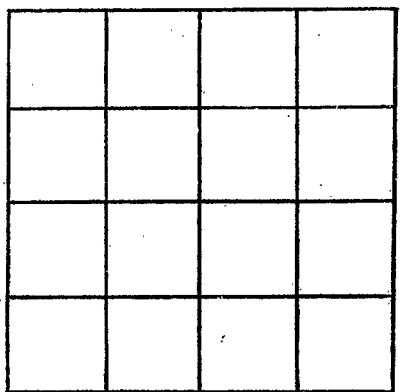

SECTION _____

Please indicate well location X.

ADDITIONAL INFORMATION

A series of horizontal lines for recording additional information, starting below the 'ADDITIONAL INFORMATION' header and extending to the bottom of the page.

If more than one screen, show locations of each on sketch.