

Scott
L43
5-15-79

MISSISSIPPI
BOARD OF WATER COMMISSIONERS
416 North State Street
Jackson, Mississippi 39201

CODED

WATER WELL DRILLERS LOG

5-15-79 date well completed 1979 Thomas & Son firm name Scott county well located

LANDOWNER: Ford Const. Co.
Forest, MS.
(mailing address)

WELL LOCATION:
sec 21 T 6 N R 3 E
At I 20 & 35 Intersect
(distance) (direction) (nearest town)

WELL PURPOSE: Residential
(home, irrigation, municipal, industrial)

WELL COMPLETION DATA:
(1) diameter (inches) 4
(2) total depth (feet) 630
(3) static water level (feet) 201 ^{below}/_{above} top of ground.
(4) casing PC 315
(material) (depth)
4 If telescope see back.
(size)
(5) screen 60 570
(length) (depth to top)
2" 85/100 PC
(size) (material)
(6) pump 5 50
(HP) (yield gpm)
Eke.
(type power)
(7) electric log NO
(yes or no)
(organization running log)
(8) how well bottom plugged Point

description of formations encountered	from	to
fine clay	0	30
Blue Chalk	30	103
SLATE Rock & Chalk	103	130
Soft Chalk	130	195
STR Chalk & Fine Sand	195	210
Brown Sand	210	240
Fine Silt & Chalk	240	285
Lignite	285	288
Fine Sand & Chalk	288	364
Chalk	364	385
Coarse Sand	385	391
Hard Black Dirt	391	458
Shred Rock & Chalk	458	514
Sand	514	518
Hard Black Dirt	518	568
Good Sand	568	630

CODED

Miss. Board of Water Comm.


JUN 27 1979

RECEIVED

DRILLERS REMARKS:

If well telescopes please sketch and show depths.

GROUND LEVEL

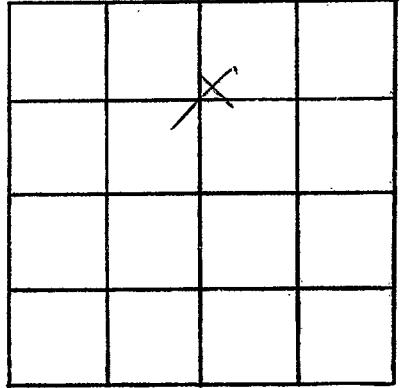

SECTION 21

Please indicate well location X.

ADDITIONAL INFORMATION

If more than one screen, show locations of each on sketch.