

MISSISSIPPI DEPARTMENT OF NATURAL RESOURCES

Bureau of Land and Water Resources

Southport Mall

P.O. Box 10631

Jackson, Mississippi 39209

WATER WELL DRILLERS LOG

CODED

SCOTT
L48

MAY 1 1981 E.M. Bud CRESSWELL Scott
date well completed firm name county well located

| LANDOWNER: | description of formations encountered | from | to |
|--|---------------------------------------|------|-----|
| R. W. PENN | | | |
| Forest, Ms. (mailing address) | Surface deposits | 0 | 30 |
| | blue clay | 30 | 180 |
| | Muddy branch | 180 | 210 |
| | Sandy shale | 210 | 285 |
| | Timber land | 285 | 330 |
| | rough shale | 330 | 360 |
| | Sandy shale | 360 | 380 |
| | Shale | 380 | 440 |
| | Shale - rocks | 440 | 500 |
| | Sand - shale - streak | 500 | 660 |
| | Sand - good | 660 | 700 |
| WELL LOCATION: sec. 28 T 6 N R 8 E 1 miles West of Forest (distance) (direction) (nearest town) | | | |
| WELL PURPOSE: Home (home, irrigation, municipal, industrial) | | | |
| WELL COMPLETION DATA: (1) diameter (inches) 4 | | | |
| (2) total depth (feet) 700 | | | |
| (3) static water level (feet) 235 below top of ground. | | | |
| (4) casing Steel, 680 (material), (depth), 4 (size) if telescope see back. | | | |
| (5) screen 20, 680 (length), (depth to top), 2, STAINLESS (size), (material) | | | |
| (6) pump 3, 25 (HP), (yield gpm) | | | |
| (type power) | | | |
| (7) electric log Yes (yes or no) State (organization running log) | | | |
| (8) Check well bottom plugged Puck wash | | | |

CODED

RECEIVED


MAY 19 1987

Department of Natural Resources
Bureau of Land & Water Resources

DRILLERS REMARKS:

If well telescopes please sketch and show depths.

GROUND LEVEL

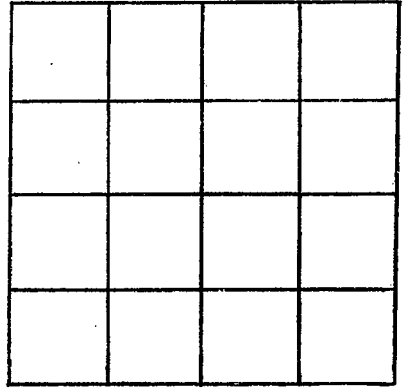

SECTION _____

Please indicate well location X.

ADDITIONAL INFORMATION

If more than one screen, show locations of each on sketch.