

MISSISSIPPI DEPARTMENT OF NATURAL RESOURCES

Bureau of Land and Water Resources

P.O. Box 10631

Jackson, Mississippi 39209

WATER WELL DRILLERS LOG

COUNTY WELL LOCATED SCOTT	
WELL NUMBER L	CODED
DATE WELL COMPLETED 8-17-88	

PERMIT NUMBER
NAME OF DRILLING FIRM GARDNER DRILLING
SEBASTOL, MS. 39358

NAME & MAILING ADDRESS OF LANDOWNER FOREST LAWN			
800 Box 409			
FOREST, MS. 39074			
WELL LOCATION:	SEC	TOWNSHIP	RANGE
	4	6 N	8 E
DISTANCE	DIRECTION	NEAREST TOWN	
1 Miles	N	of FOREST	
OTHER LANDMARK			
WELL PURPOSE: Home <u>Irrigation</u> Municipal, Industrial, Fish Pond, etc.			

PUMP DATA		
PUMP TYPE (Circle One): <u>Submersible</u> Turbine, Jet, Flowing Well, Other (Describe) _____		
POWER TYPE (Circle One): <u>Electric</u> Tractor, Diesel, Gasoline, Butane, Other (Describe) _____		
Pump Capacity (GPM)	No. of Stages	Setting Depth
30	12	140 FT.
PUMP TEST		
Well yielded 30 GPM with a drawdown of 22 ft. after 4 hours of pumping		


WELL DATA		
Well Depth 310'	Casing Diameter (In.) 4	Casing Length (Ft.) 20
Type of Casing PVC	Hole Depth 310	Depth to Static Water Level 75'
TYPE OF COMPLETION: (Circle One or More): <u>Gravel Packed</u> Underreamed, Telescoped, Natural Development, Open Hole, Other (Describe) _____		
Top of Lap Pipe or Reduction in Casing		
FEET	IF TELESCOPED OR MORE THAN ONE SCREEN: USE BACK PAGE	

LOG DATA	
TYPE OF LOG RUN (Circle One): No Log Run, Electric, Gamma Ray, Density, Sonic, Neutron, Other (Describe) _____	
Name of Organization Running Log	

SCREEN DATA		
Diameter - Inches 2	Length - Feet 10'	Slot Size - Inches 8
Screen Type STAINLESS STEEL	Depth to Bottom - Feet 310	


GEOLOGIC DATA (Office Use Only)			
Surface Elev.	Geologic Unit	Unit Thickness	Depth to Top
Subs. SWL	Date	Analysis	Aquifer Test
Driller's Remarks			

DESCRIPTION OF FORMATIONS ENCOUNTERED	FROM	TO
YELLOW CLAY	0	10
CLAY	10	205
CLAY + SAND HEDGES	205	275
SAND	275	310

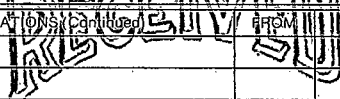 FEB 9 1989	
Department of Natural Resources Bureau of Land & Water Resources	
IF MORE SPACE IS NEEDED, USE BACK	

If well telescopes please
sketch and show depths.

GROUND LEVEL

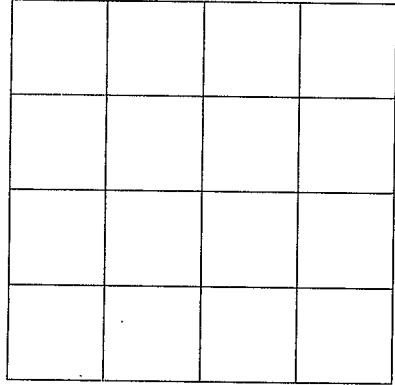

SECTION _____

Please indicate well location X.

ADDITIONAL INFORMATION

Lined area for providing additional information, consisting of approximately 25 horizontal lines.

If more than one screen,
show location of each on sketch.