

MISSISSIPPI DEPARTMENT OF ENVIRONMENTAL QUALITY
Bureau of Land and Water Resources

P. O. Box 10631
Jackson, MS 39289-0631
WATER WELL DRILLERS LOG

COUNTY WELL LOCATED SCOTT	
WELL NUMBER L 2005	CODED
DATE WELL COMPLETED 9-16-94	

PERMIT NUMBER
NAME OF DRILLING FIRM GARDNER DRILLING
SEBASTOPOL MS.

NAME & MAILING ADDRESS OF LANDOWNER SCOTT COUNTY Co-OP		
P.O. Box 248		
FOREST, MS. 39874		
WELL LOCATION: SEC	TOWNSHIP	RANGE
16	6	N 8 E S W
DISTANCE	DIRECTION	NEAREST TOWN
1 Miles	W	of FOREST
OTHER LANDMARK		
WELL PURPOSE: Home, Irrigation, Municipal, Industrial, Fish Pond, etc. FEED MILL		

PUMP DATA		
PUMP TYPE (Circle One): <input checked="" type="checkbox"/> Submersible Turbine, Jet Flowing Well, Other (Describe) _____		
POWER TYPE (Circle One): <input checked="" type="checkbox"/> Electric Tractor, Diesel, Gasoline, Butane, Other (Describe) _____ H/P L		
Pump Capacity (GPM)	No. of Stages	Setting Depth
10	12	160 FT.
PUMP TEST		
Well yielded 20 GPM with a drawdown of 10 ft. after 3 hours of pumping		

WELL DATA		
Well Depth 380	Casing Diameter (In.) 4	Casing Length (Ft.) 225
Type of Casing PVC	Hole-Depth 380	Depth to Static Water Level 96'
TYPE OF COMPLETION: (Circle One or More): Gravel Packed, Underreamed, <input checked="" type="checkbox"/> Telescoped, Natural Development, Open Hole, Other		
Top of Lap Pipe or Reduction in Casing 220 FEET		
IF TELESCOPED OR MORE THAN ONE SCREEN: USE BACK PAGE		

LOG DATA	
TYPE OF LOG RUN (Circle One): No Log Run, Electric, Gamma Ray, Density, Sonic, Neutron, Other (Describe) _____	
Name of Organization Running Log	

SCREEN DATA		
Diameter - Inches 2	Length - Feet 20	Slot Size - Inches 5/8
Screen Type PVC RIB		Depth to Bottom - Feet 380'


GEOLOGIC DATA (Office Use Only)			
Surface Elev.	Geologic Unit	Unit Thickness	Depth to Top
Subs. SWL	Date	Analysis	Aquifer Test
Driller's Remarks			

DESCRIPTION OF FORMATIONS ENCOUNTERED	FROM	TO
Yellow clay	0	25
Clay & Rock ledges	25	305
Clay & Sand ledges	305	350
SAND	350	380

FORMATIONS (Continued)	FROM	TO
RECEIVED		
AUG 16 1995		
Dept. of Environmental Quality Office of Land & Water Resources		
IF MORE SPACE IS NEEDED, USE BACK		

If well telescopes please
sketch and show depths.

GROUND LEVEL

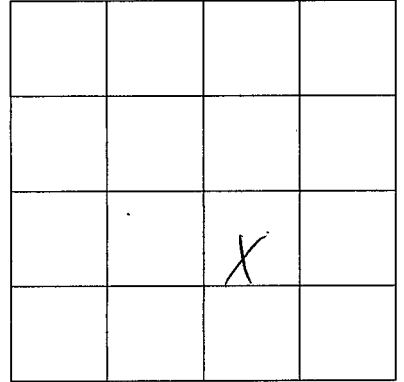

SECTION 18

Please indicate well location X.

ADDITIONAL INFORMATION

If more than one screen,
show location of each on sketch.