

SCOTT  
 KMB  
 9-16-63

WATER WELL DRILLERS LOG

2

Date: 9-16-1963, Driller: Layne-Central Co. County: Scott

*Sunbeam Mfg.*

(Name)

(1) Owner of Land: Romeo Guest & Associates

(Name)

Forest, Mississippi

(Address)

(2) Location: 1/4, SW 1/4, Sec. 17, T. R.

miles

of

(distance)

(direction)

(Nearest Town)

(3) Topography:

(Hilly)

(Flat)

(Level)

(4) Purpose of Well: Industrial

(Domestic Irrigation  
 Municipal, Industrial, Other)

Description & Color of Materials Sand, Clay, Red Clay, Shell, etc.	Thick- ness Feet	Depth Feet
yellow clay	15	15
blue clay	49	64
hard shale	96	160
fine sand, stks shale	20	180
shale, stks fine sand	40	220
sand	70	290
clay	6	296

Information upon completion of well:

(1) Diameter, 12 inches.

(2) Total Depth 294' feet.

(3) Water Level 71' feet below top of ground.

(4) Cased to 220', Size 12"

(5) Screen: Size 8", Length 60'


(6) Were any formations sealed against pollution?

yes,  no.

If YES depth of formation 220'

Why required

Drillers Remarks:

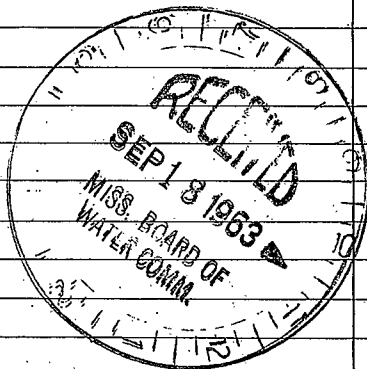

(Use Back Side)

Well No.

