

MISSISSIPPI BOARD OF WATER COMMISSIONERS

WATER WELL DRILLERS LOG

Scott
M 6
8-66


Date: 8/16, 1966, Driller: Scott Drilling Co. Scott
(Name)

(1) Owner of Land:	Description & Color of Materials Sand, Clay, Red Clay, Shell, etc.	Thick- ness Feet	Depth Feet
(Name) <u>A. M. Assum</u> (Address) <u>Forest, Miss.</u>	<u>Brown clay</u>	<u>0</u>	<u>215</u>
(2) Location: <u>SE 1/4, SW 1/4, Sec. 16 T. 18 N. R. 6 E</u> <u>4</u> miles <u>East</u> of <u>Forest</u> (distance) (direction) (Nearest Town)	<u>blue clay</u>		<u>61</u>
(3) Topography: <u>Level</u> (Hilly) (Flat) (Level)	<u>Clay + sh. (limestone)</u>		<u>71</u>
(4) Purpose of Well: <u>Chicken House</u> (Domestic Irrigation Municipal, Industrial, Other)	<u>Clay + mky. sand</u>		<u>81</u>
	<u>Clay</u>		<u>184</u>
	<u>fine sand + sh. clay</u>		<u>204</u>
	<u>fine sand</u>		<u>245</u>
	<u>fine sand</u>		<u>264</u>

Information upon completion of well:

- (1) Diameter 2 inches.
- (2) Total Depth 264 feet.
- (3) Water Level 81 feet below top of ground.
- (4) Cased to 249, Size 2"
- (5) Screen: Size 2", Length 15 ft
- (6) Were any formations sealed against pollution?
 yes, no.

If YES depth of formation _____
 Why _____
 Drillers Remarks: _____

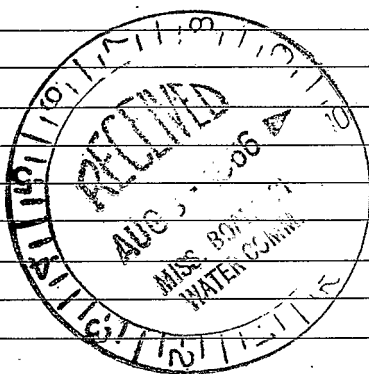

(Use Back Side)

Well No.

