

SCOTT MISSISSIPPI BOARD OF WATER COMMISSIONERS

LMJ
6-15-63

WATER WELL DRILLERS LOG

Date: 6/15, 1963, Driller: Frank Orlig, Sen. County Scott
(Name)


(1) Owner of Land: W M A G.
(Name)
Frank Orlig
(Address)
(2) Location: 1/4, 1/4, Sec. 18 60 9C T. R.
2 miles East of Forest
(distance) (direction) (Nearest Town)
(3) Topography: X
(Hilly) (Flat) (Level)
(4) Purpose of Well: Office
(Domestic Irrigation
Municipal, Industrial, Other)

Description & Color of Materials Sand, Clay, Red Clay, Shell, etc.	Thick- ness Feet	Depth Feet
Brown Clay	0	22
Blue "		52
Clay		92
Clay + Shly Sand		102
Clay		122
Clay + Shly Sand		132
Clay		142
Clay + Shly Sand		172
Shly. Clay		192
Shly Sand + Shly Clay		202
Clay + Shly Sand		212
Fine Sand		222
Fine Sand		242
Good Sand		238

Information upon completion of well:

(1) Diameter 2" inches.
(2) Total Depth 246 feet.
(3) Water Level 51 feet below top of ground.
(4) Cased to 236, Size 2"
(5) Screen: Size 2", Length 10ft.
(6) Were any formations sealed against pollution?
_____ yes, X no.

If YES depth of formation _____
Why _____
Drillers Remarks: _____

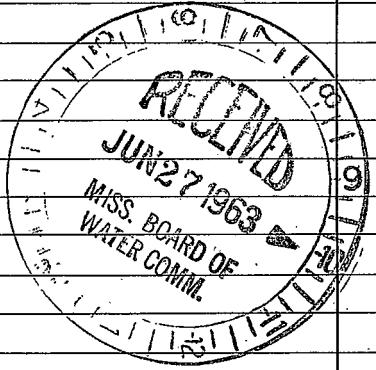

(Use Back Side)

Well No.

