

M8

Scott
4 X 8
2-68

MISSISSIPPI
BOARD OF WATER COMMISSIONERS
416 North State Street
Jackson, Mississippi 39201

WATER WELL DRILLERS LOG

Feb. 19 Wilkinson Drilling Service SCOTT
date well completed firm name county well located

LANDOWNER: Harold Dennis
Forest, Miss
(mailing address)

description of formations encountered	from	to
<u>Yellow clay</u>	<u>0</u>	<u>20</u>
<u>Sand & clay</u>	<u>20</u>	<u>85</u>
<u>Rock</u>	<u>85</u>	<u>87</u>
<u>Brown shale & sand</u>	<u>87</u>	<u>170</u>
<u>Sand</u>	<u>170</u>	<u>220</u>
<u>Fine sand</u>	<u>220</u>	<u>230</u>

WELL LOCATION:
sec. 17 T. 6 N. R. 8 E.
3 miles East of Forest
(distance) (direction) (nearest town)

WELL PURPOSE: home
(home, irrigation, municipal, industrial)


- WELL COMPLETION DATA:
- (1) diameter (inches) 2"
 - (2) total depth (feet) 220'
 - (3) static water level (feet) 51' ^{below}/_{above} top of ground.
 - (4) casing GALV., 215'
(material) (depth)
2"
(size) if telescope see back.
 - (5) screen 5', 215'
(length) (depth to top)
2, brass
(size) (material)
 - (6) pump 1 1/2, 13
(HP) (yield gpm)
elec
(type power)
 - (7) electric log NO
(yes or no)
(organization running log)
 - (8) how well bottom plugged 2" B.W.V.

DRILLERS REMARKS:



If well telescopes please sketch and show depths.

GROUND LEVEL

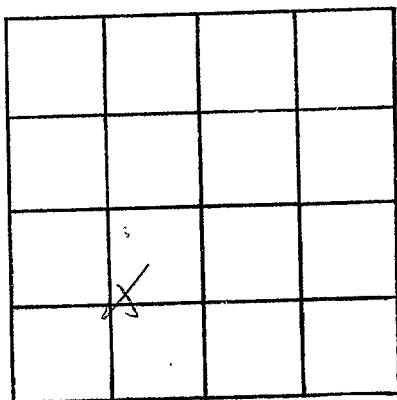

SECTION 17

Please indicate well location X.

ADDITIONAL INFORMATION

If more than one screen, show locations of each on sketch.