

SCOTT MISSISSIPPI BOARD OF WATER COMMISSIONERS

M-10

8-10-65

WATER WELL DRILLERS LOG

Date: 8/10, 1965, Driller: Forest Drilling ^{Sec.} Scott _{County}
 (Name)


(1) Owner of Land: James L. Hellingworth
 (Name)
Rt 1 Forest, Miss
 (Address)
 (2) Location: 1/4, 1/4, Sec. T R
7 miles East Forest of Old Hwy 80
 (distance) (direction) (Nearest Town)
 (3) Topography: Hilly (Hilly) Flat (Flat) Level (Level)
 (4) Purpose of Well: Home
 (Domestic Irrigation, Municipal, Industrial, Other)

Description & Color of Materials Sand, Clay, Red Clay, Shell, etc.	Thick- ness Feet	Depth Feet
Clay	0	42
Clay + mky sand		52
Soft shale + silt. sand		92
7 sand + silt. clay		102
Clay + silt. sand		122
fine sand + clay		142
Clay		146
fine sand		178

Information upon completion of well:

(1) Diameter 2 inches.
 (2) Total Depth 178 feet.
 (3) Water Level 45 feet below top of ground.
 (4) Cased to 168, Size 2"
 (5) Screen: Size 2", Length 10ft.
 (6) Were any formations sealed against pollution?
 _____ yes, no.

If YES depth of formation _____
 Why _____
 Drillers Remarks: _____

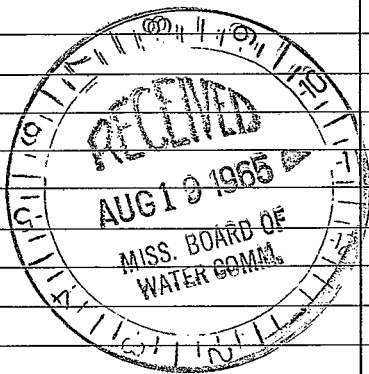

(Use Back Side)

Well No.

