

SCOTT
M 11

MISSISSIPPI BOARD OF WATER COMMISSIONERS

6-15-65

WATER WELL DRILLERS LOG

Date: 6-15, 19 65, Driller: Forest Dilling, Jr. Scott
(Name)

(1) Owner of Land: J. E. Calhoun
(Name)
Forest, Miss.
(Address)

(2) Location: 1/4, 1/4, Sec. 4 T. R.
6 1/2 miles East of Forest
(distance) (direction) (Nearest Town)
Old Hwy 80

(3) Topography: (Hilly) (Flat) (Level)

(4) Purpose of Well: Chicken Farm
(Domestic Irrigation
Municipal, Industrial, Other)

Description & Color of Materials Sand, Clay, Red Clay, Shell, etc.	Thick- ness Feet	Depth Feet
Brown Clay		22
Clay + Silts Sand		2
Clay		105
Fine Sand		112
F Sand + Silts Clay		172
F Sand		200

Information upon completion of well:

(1) Diameter 2 inches.

(2) Total Depth 200 feet.

(3) Water Level 90' feet below top of ground.

(4) Cased to 190, Size 2"


(5) Screen: Size 2", Length 10ft.

(6) Were any formations sealed against pollution?
yes, no.

If YES depth of formation _____

Why _____

Drillers Remarks: _____

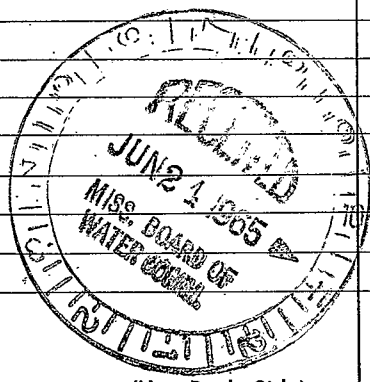

(Use Back Side)

Well No.

