

SCOTT MISSISSIPPI BOARD OF WATER COMMISSIONERS

M 13

5-26-65 WATER WELL DRILLERS LOG

Date: 5/26, 1965, Driller: Forest Hilling County Scott  
 (Name)

(1) Owner of Land: A. D. Raley  
 (Name)  
Forest, Miss.  
 (Address)

(2) Location: 1/4, 1/4, Sec. 1 T R  
4 miles East of Forest  
 (distance) (Direction) (Nearest Town)

(3) Topography:  (Hilly)  (Flat)  (Level)

(4) Purpose of Well: Chicken Farm  
 (Domestic Irrigation  
 Municipal, Industrial, Other)

Description & Color of Materials Sand, Clay, Red Clay, Shell, etc.	Thick- ness Feet	Depth Feet
Clay		10
Rock		17
Brown Clay		22
Blue Clay		30
Rock		37
Blue Clay		52
Blue Clay + Sh. Lime Bed		62
Clay		92
Fine Sand		100
Clay		102
Fine Sand		107
Fine Sand + Sh. Clay		232
Fine Sand		262
Fine Sand		283

Information upon completion of well:

(1) Diameter 2 inches.

(2) Total Depth 283 feet.

(3) Water Level 95 feet below top of ground.


(4) Cased to 273, Size 2"

(5) Screen: Size 2", Length 10ft

(6) Were any formations sealed against pollution?  
 yes,  no.

If YES depth of formation \_\_\_\_\_  
 Why \_\_\_\_\_

Drillers Remarks: \_\_\_\_\_  
 \_\_\_\_\_  
 \_\_\_\_\_

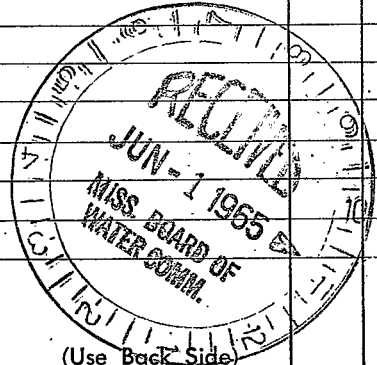

Well No. \_\_\_\_\_

