

SCOTT
M 17

WATER WELL DRILLERS LOG

FOREST DRILLING SERVICE

Date: 7/5, 1962, Driller: 231 Highway 35 North County: Scott
FOREST, MISSISSIPPI

(1) Owner of Land: L. A. Riquelme
 (Name)
Rt 1 Forest, Miss
 (Address)

(2) Location: 1/4, 1/4, Sec. 3 6W 11E
 (North) (East) (Section) (Township) (Range)
6 1/2 miles East of Forest
 (Distance) (direction) (Nearest Town)
Old Hwy 80

(3) Topography: X
 (Hilly) (Flat) (Level)

(4) Purpose of Well: Home use
 (Domestic Irrigation
 Municipal, Industrial, Other)

Description & Color of Materials Sand, Clay, Red Clay, Shell, etc.	Thick- ness Feet	Depth Feet
<u>red clay</u>	<u>0</u>	<u>16</u>
<u>sand</u>	<u>13</u>	<u>29</u>
<u>clay</u>	<u>43</u>	<u>82</u>
<u>fine sand + clay</u>	<u>10</u>	<u>92</u>
<u>clay</u>	<u>40</u>	<u>132</u>
<u>fine sand, shells, clay</u>	<u>30</u>	<u>162</u>
<u>fine sand</u>	<u>30</u>	<u>192</u>
<u>hard sand</u>	<u>14</u>	<u>206</u>

Information upon completion of well:

(1) Diameter 2" inches.

(2) Total Depth 206 feet.

(3) Water Level 5.3 feet below top of ground.

(4) Cased to 196, Size 2"


(5) Screen: Size 2", Length 10ft

(6) Were any formations sealed against pollution?
yes, X no.

If YES depth of formation _____

Why _____

Drillers Remarks: _____

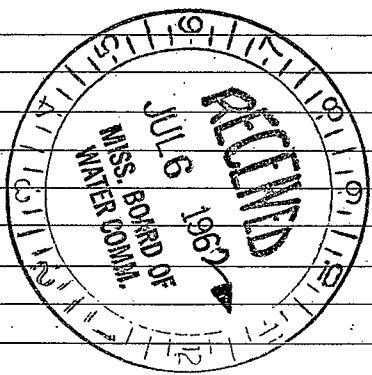

(Use Back Side)

Well No.

