

SCOTT

MISSISSIPPI BOARD OF WATER COMMISSIONERS

M 19  
8-25-61

WATER WELL DRILLERS LOG

M 2 ✓

Date: 8/25, 1961, Driller: James McGee County Scott.

(Name)

(1) Owner of Land: Archie Taylor  
(Name)  
This well located about 7 miles East  
of Forest on Hwy. 80.  
(Address)

(2) Location: 1/4, 1/4, Sec. E T R  
7 miles East, of Forest  
(distance) \* (direction) (Nearest Town)

(3) Topography:  (Hilly) (Flat) (Level)

(4) Purpose of Well: Domestic.  
(Domestic Irrigation  
Municipal, Industrial, Other)

Description & Color of Materials Sand, Clay, Red Clay, Shell, etc.	Thick- ness Feet	Depth Feet
Brown clay.	0-24	
Blue clay.	24-42	
Clay & mucky sand.	42-117	
Fine sand.	117-202	
Sand. (Screen setting)	202-220	

Information upon completion of well:

(1) Diameter 2 inches.

(2) Total Depth 220' feet.

(3) Water Level 68 feet below top of ground.

(4) Cased to 210', Size 2"


(5) Screen: Size 2", Length 10'

(6) Were any formations sealed against pollution?  
yes,  no.

If YES depth of formation \_\_\_\_\_

Why \_\_\_\_\_

Drillers Remarks: Good well.

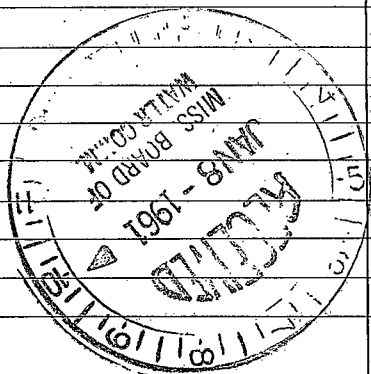

(Use Back Side)

Well No.

