

SCOTT

MISSISSIPPI BOARD OF WATER COMMISSIONERS

3-16-66

WATER WELL DRILLERS LOG

Date: 3-14, 1966, Driller: LEACH County SCOTT

(1) Owner of Land: Jacob Hollingsworth

PH Lake miss

(2) Location: 1/4, 1/4, Sec 16 T. R.

3 miles WEST of LAKE

(3) Topography: (Hilly) (Flat) (Level)

(4) Purpose of Well: (Domestic Irrigation) (Municipal, Industrial, Other)

Description & Color of Materials Sand, Clay, Red Clay, Shell, etc.

Thickness Feet Depth Feet

clay	30	30
Sand	20	50
Blue clay	45	95
Sand	78	172

Information upon completion of well:

(1) Diameter 2 inches.

(2) Total Depth 172 feet.

(3) Water Level 25 feet below top of ground.

(4) Cased to 143, Size 2"

(5) Screen: Size 2, Length 10

(6) Were any formations sealed against pollution? yes, no.

If YES depth of formation


Why

Drillers Remarks:

Yield in gpm: 20

Size pump: 1 1/2 HP air

Type power:

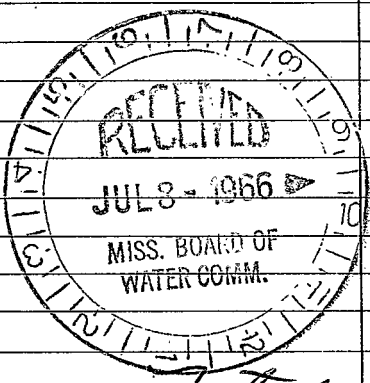

Total 173

