

SCOTT

MISSISSIPPI BOARD OF WATER COMMISSIONERS

11-10-65

WATER WELL DRILLERS LOG

Date: 11-10, 1965, Driller: LEACH, County: SCOTT

(1) Owner of Land: ASA JONES (Name) Forest MISS (Address) (2) Location: 1/4, 1/4, Sec. 1, T. R., 3 miles East of Forest (distance) (direction) (Nearest Town) (3) Topography: (Hilly) (Flat) (Level) (4) Purpose of Well: (Domestic-Irrigation) (Municipal; Industrial, Other)


Table with 3 columns: Description & Color of Materials, Thickness Feet, Depth Feet. Rows include clay, sand, blue clay, shell, sand & clay, sand.

Information upon completion of well:

(1) Diameter 2 inches. (2) Total Depth 254 feet. (3) Water Level 30 feet below top of ground. (4) Cased to 244, Size 2". (5) Screen: Size 2", Length 10. (6) Were any formations sealed against pollution? yes, no.

If YES depth of formation Why

Drillers Remarks: Yield in gpm: 30 Size pump: 2 Hp air. Type power:

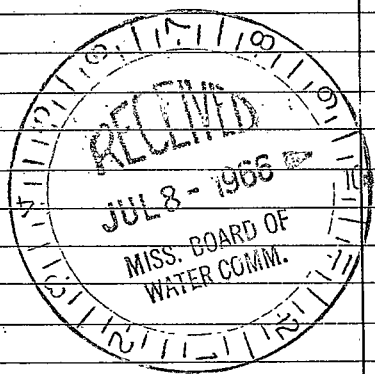

Total 254

Retain this copy for your office files.

