

SCOTT MISSISSIPPI BOARD OF WATER COMMISSIONERS

M 24 7

10-28-65 WATER WELL DRILLERS LOG

Date: 10/28, 1965, Driller: Forest Dilling County: Scott
 (Name)

(1) Owner of Land: A. M. Sesans
 (Name) farm
Rt 1 Forest
 (Address)

(2) Location: 1/4, 1/4, Sec. 17 T. R.
4 miles East of Forest
 (distance) (direction) (Nearest Town)

(3) Topography: (Hilly) (Flat) (Level)

(4) Purpose of Well: Children
 (Domestic Irrigation
 Municipal, Industrial, Other)

Description & Color of Materials Sand, Clay, Red Clay, Shell, etc.	Thick- ness Feet	Depth Feet
<u>Brown Clay</u>		<u>25</u>
<u>blue clay</u>		<u>32</u>
<u>Clay + sh. small</u>		<u>42</u>
<u>Clay + shell</u>		<u>59</u>
<u>Clay</u>		<u>62</u>
<u>Clay + sh. m. sand</u>		<u>102</u>
<u>Clay</u>		<u>112</u>
<u>Clay + sh. m. sand</u>		<u>132</u>
<u>Fine sand + sh. cl.</u>		<u>142</u>
<u>Fine sand</u>		<u>199</u>

Information upon completion of well:

(1) Diameter 2 inches.

(2) Total Depth 199 feet.

(3) Water Level 74 feet below top of ground.

(4) Cased to 189, Size 2"


(5) Screen: Size 2", Length 10ft.

(6) Were any formations sealed against pollution?
 yes, no.

If YES depth of formation _____

Why _____

Drillers Remarks: _____

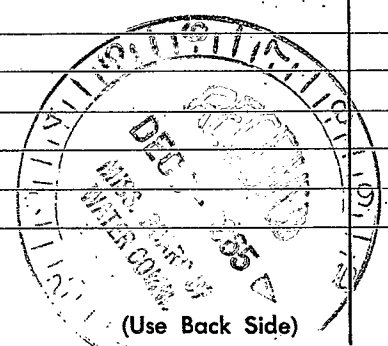

Well No.

