

SCOTT MISSISSIPPI BOARD OF WATER COMMISSIONERS

M 26

10-5-62 WATER WELL DRILLERS LOG

Date: 10/5, 1962, Driller: Forest Oly Sax County Scott
(Name)


(1) Owner of Land: <u>Nolla Gutwood</u> (Name)	Description & Color of Materials Sand, Clay, Red Clay, Shell, etc.	Thick- ness Feet	Depth Feet
<u>Rt. 1 Forest</u> (Address)	<u>yellow clay</u>		<u>29</u>
(2) Location: <u>1/4, 1/4, Sec. 16 T. R.</u>	<u>blue clay</u>		<u>70</u>
<u>5 miles East of Forest</u> (distance) (direction) (Nearest Town)	<u>Clay + sand</u>		<u>131</u>
(3) Topography: <u>X</u> (Hilly) (Flat) (Level)	<u>Fine sand</u>		<u>145</u>
(4) Purpose of Well: <u>Chickens</u> (Domestic Irrigation, Municipal, Industrial, Other)	<u>Shale</u>		<u>150</u>
	<u>Fine sand</u>		<u>161</u>
	<u>sand</u>		<u>171</u>
	<u>Shale</u>		<u>179</u>
	<u>red sand</u>		<u>180</u>
	<u>Fine sand</u>		<u>190</u>

Information upon completion of well:

- (1) Diameter 2" inches.
- (2) Total Depth 190 feet.
- (3) Water Level 60 feet below top of ground.
- (4) Cased to 180, Size 2"
- (5) Screen: Size 2", Length 10ft.
- (6) Were any formations sealed against pollution?
 yes, no.

If YES depth of formation _____
Why _____

Drillers Remarks: _____

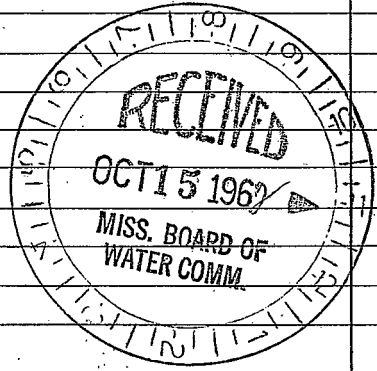

(Use Back Side)

Well No.

