

SCOTT MISSISSIPPI BOARD OF WATER COMMISSIONERS

M 28  
9-27-63

WATER WELL DRILLERS LOG

6

Date: 9/27, 19 63, Driller: East Dalgrow County Scott  
(Name)

(1) Owner of Land: Fred Gaddis  
(Name)  
Frest Dingo  
(Address)  
Wardley Farm

(2) Location:  $\frac{1}{4}$ ,  $\frac{1}{4}$ , Sec. 4 T. 4 R. 4  
6 miles 7/8 of Fossil  
(distance) (direction) (Nearest Town)

(3) Topography: X  
(Hilly) (Flat) (Level)

(4) Purpose of Well: Chickens  
(Domestic Irrigation  
Municipal, Industrial, Other)

Description & Color of Materials Sand, Clay, Red Clay, Shell, etc.	Thick- ness Feet	Depth Feet
<u>Clay</u>	<u>0</u>	<u>76</u>
<u>Clay + sh. fine sand</u>		<u>92</u>
<u>" " sand</u>		<u>132</u>
<u>Clay</u>		<u>152</u>
<u>Clay + sh. fine sand</u>		<u>192</u>
<u>Fine sand + sh. clay</u>		<u>212</u>
<u>Clay</u>		<u>222</u>
<u>Fine sand</u>		<u>232</u>
<u>Good sand</u>		<u>246</u>

Information upon completion of well:

(1) Diameter 2 inches.

(2) Total Depth 243 feet.

(3) Water Level 74 feet below top of ground.

(4) Cased to 231, Size 2".


(5) Screen: Size 2", Length 12ft.

(6) Were any formations sealed against pollution?  
X yes, X no.

If YES depth of formation \_\_\_\_\_

Why \_\_\_\_\_

Drillers Remarks: \_\_\_\_\_

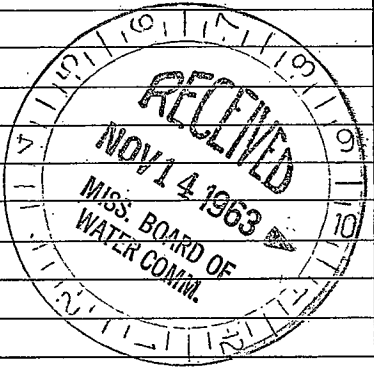

(Use Back Side)

Well No.

