

SCOTT
M 30
3-27-63

WATER WELL DRILLERS LOG

Date: 3/27, 1963, Driller: Forest Oil & Gas County Scott
(Name)

(1) Owner of Land: James Heflin
(Name)
RT 1 Lake, Miss
(Address)

(2) Location: 1/4, 1/4, Sec. 16 T. 9N R. 6W
6 miles east of Forest
(distance) (direction) (Nearest Town)

(3) Topography: (Hilly) (Flat) (Level)

(4) Purpose of Well: Home
(Domestic Irrigation
Municipal, Industrial, Other)

Description & Color of Materials Sand, Clay, Red Clay, Shell, etc.	Thick- ness Feet	Depth Feet
<u>Brown Clay</u>		<u>24</u>
<u>Clay</u>		<u>42</u>
<u>Clay & mky sand</u>		<u>72</u>
<u>Clay</u>		<u>82</u>
<u>mky sand & clay</u>		<u>112</u>
<u>Fine sand</u>		<u>202</u>

Information upon completion of well:

(1) Diameter 2" inches.

(2) Total Depth 220 feet.

(3) Water Level 40 feet below top of ground.

(4) Cased to 210, Size 2"


(5) Screen: Size 2", Length 10 ft.

(6) Were any formations sealed against pollution?
yes, no.

If YES depth of formation _____

Why _____

Drillers Remarks: _____

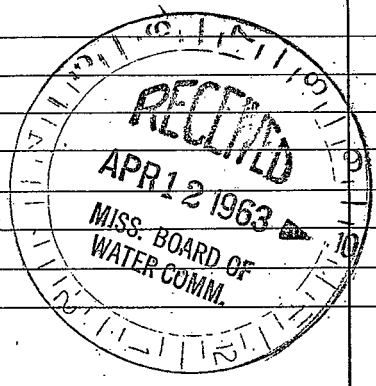

(Use Back Side)

Well No.

[The page contains extremely faint and illegible text, likely bleed-through from the reverse side of the document. No specific words or phrases can be discerned.]