

SCOTT MISSISSIPPI BOARD OF WATER COMMISSIONERS

M31

11-20-62

WATER WELL DRILLERS LOG

Date: 11-20, 1962, Driller: B Faust Drlg. Serv. Co. County Scott  
 (Name)

(1) Owner of Land: Bice Sparks  
 (Name)  
Rt 3 Forest, Miss.  
 (Address)

(2) Location: 1/4, 1/4, Sec. 2 T. R  
5 miles Northwest of Forest  
 (distance) (direction) (Nearest Town)

(3) Topography: X  
 (Hilly) (Flat) (Level)

(4) Purpose of Well: Chicken house  
 (Domestic Irrigation) Home  
 Municipal, Industrial, Other)

Description & Color of Materials Sand, Clay, Red Clay, Shell, etc.	Thick- ness Feet	Depth Feet
<u>yellow clay</u>	<u>0</u>	<u>18</u>
<u>Blue clay</u>		<u>92</u>
<u>silt + soft clay</u>		<u>132</u>
<u>Blue clay</u>		<u>162</u>
<u>Clay + lots silt + lignite</u>		<u>202</u>
<u>fine sand + sh. shale</u>		<u>228</u>
<u>fine sand</u>		<u>236</u>
<u>shale</u>		<u>244</u>
<u>fine sand + sh. shale</u>		<u>252</u>
<u>sand</u>		<u>262</u>

Information upon completion of well:

(1) Diameter 2" inches.

(2) Total Depth 262 feet.

(3) Water Level 95 feet below top of ground.

(4) Cased to 252, Size 2"


(5) Screen: Size 2", Length 10ft.

(6) Were any formations sealed against pollution?  
no yes, X no.

If YES depth of formation \_\_\_\_\_

Why \_\_\_\_\_

Drillers Remarks: \_\_\_\_\_

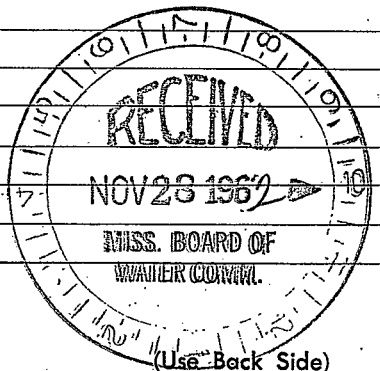

Well No.

