

SCOTT MISSISSIPPI BOARD OF WATER COMMISSIONERS

M 34
10-7-61

WATER WELL DRILLERS LOG

3

Date: Oct 7, 1961, Driller: Roy Wilkerson County Scott
(Name)

(1) Owner of Land: John Miller
(Name)
Lake, Miss
(Address)

(2) Location: 1/4, 1/4, Sec. 10 T 10 R 10
4 miles N.W. of Lake
(distance) (direction) (Nearest Town)

(3) Topography: Hilly
(Hilly) (Flat) (Level)

(4) Purpose of Well: Domestic
(Domestic Irrigation
Municipal, Industrial, Other)

Description & Color of Materials Sand, Clay, Red Clay, Shell, etc.	Thick- ness Feet	Depth Feet
<u>Sandy Loam</u>	<u>3</u>	
<u>yellow clay</u>	<u>17</u>	
<u>Blue Mud -</u>	<u>90</u>	
<u>Rocky</u>	<u>30</u>	
<u>Water Band</u>	<u>40</u>	

Information upon completion of well:

(1) Diameter 2 inches.

(2) Total Depth 180 feet.

(3) Water Level 60 feet below top of ground.

(4) Cased to 180 ft, Size 2"


(5) Screen: Size 2", Length 6'

(6) Were any formations sealed against pollution?
 yes, no.

If YES depth of formation _____

Why _____

Drillers' Remarks: _____

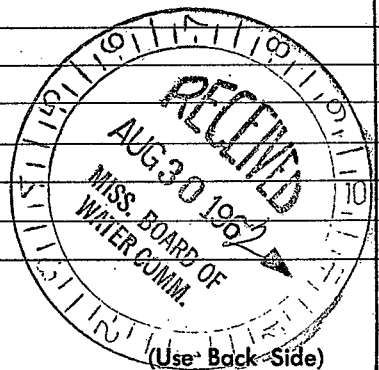

Well No.

1942

1943

1944

1945

1946

1947

1948

1949

1950

1951