

NEWTON
Scott

SCOTT

MISSISSIPPI BOARD OF WATER COMMISSIONERS

12-1-65

S M 37

WATER WELL DRILLERS LOG

Date: 12-1, 1965, Driller: LEACH County Newton
(When well drilled) (Name) (Where well is located)

(1) Owner of Land: H. L. Mabry
(Name)
LAKE MISS RT 1
(Address)

(2) Location: 1/4, 1/4, Sec. 11 T 9 R
3 miles north of LAKE
(distance) (direction) (Nearest Town)

(3) Topography: (Hilly) (Flat) (Level)

(4) Purpose of Well: Domestic Irrigation
 Municipal, Industrial, Other

Description & Color of Materials Sand, Clay, Red Clay, Shell, etc.	Thick- ness Feet	Depth Feet
Clay	20	20
Sand	35	55
Blue clay	110	165
Sand	15	180

Information upon completion of well:

(1) Diameter 2 inches.

(2) Total Depth 180 feet.

(3) Water Level 30 feet below top of ground.

(4) Cased to 175, Size 2"

(5) Screen: Size 2, Length 5'

(6) Were any formations sealed against pollution?
no.

If YES depth of formation _____


Why _____

Drillers Remarks: _____

Yield in gpm: 20

Size pump: 1 1/2 air

Type power: _____

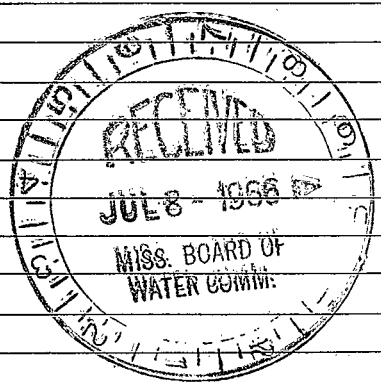

180

100
100
100