

SCOTT  
M39  
12-67

MISSISSIPPI  
BOARD OF WATER COMMISSIONERS  
416 North State Street  
Jackson, Mississippi 39201

WATER WELL DRILLERS LOG

12-7-67 date well completed     Just Dullinger firm name     Scott county well located


LANDOWNER: A.M. Assens  
Rt 1  
9 Mile, Miss.  
(mailing address)

description of formations encountered	from	to
<u>Brown Clay</u>	<u>0</u>	<u>23</u>
<u>Blue Clay</u>		<u>40</u>
<u>Clay with Sand</u>		<u>61</u>
<u>Clay</u>		<u>81</u>
<u>Clay &amp; Sandstone</u>		<u>122</u>
<u>Clay</u>		<u>196</u>
<u>Clay &amp; Fine Sand</u>		<u>204</u>
<u>Fine Sand</u>		<u>265</u>
<u>Sand</u>		<u>265</u>

WELL LOCATION:  
sec. 16 T. 6 N. R. 8 E  
6 miles East of Forest  
(distance) (direction) (nearest town)  
on Hwy 80

WELL PURPOSE: Chickens  
(home, irrigation, municipal, industrial)


- WELL COMPLETION DATA:
- (1) diameter (inches) 2"
  - (2) total depth (feet) 262
  - (3) static water level (feet) 72 below above top of ground.
  - (4) casing Galv. 252  
(material) (depth)  
2" if telescope see back.  
(size)
  - (5) screen 10 ft. 252  
(length) (depth to top)  
2" Johnson Wire Wound  
(size) (material)
  - (6) pump 3 1100 GPM  
(HP) (yield gpm)  
elect.  
(type power)
  - (7) electric log no  
(yes or no)  
(organization running log)
  - (8) how well bottom plugged Best  
value

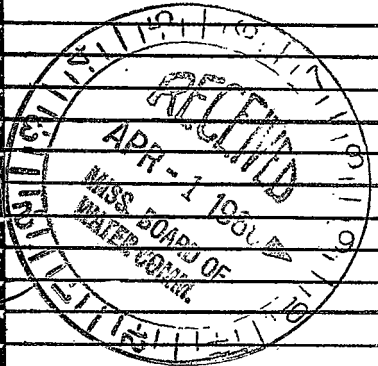

DRILLERS REMARKS:  
6/110  
50  
78

If well telescopes please sketch and show depths.

GROUND LEVEL

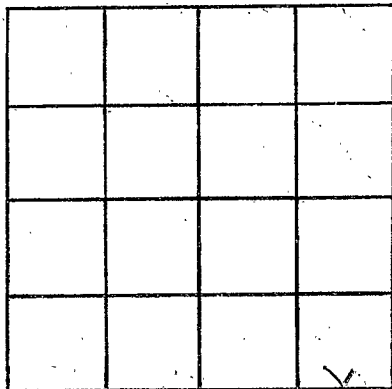

SECTION           

Please indicate well location X.

ADDITIONAL INFORMATION

If more than one screen, show locations of each on sketch.