

M40

Scott
3 M
1-67

MISSISSIPPI
BOARD OF WATER COMMISSIONERS
416 North State Street
Jackson, Mississippi 39201

WATER WELL DRILLERS LOG

1-16 67 East Drilling Scott
date well completed 19 firm name county well located


LANDOWNER	description of formations encountered	from	to
Percy W Everitt	Clay	0	18
Rt one	Sand & Shp Clay	18	41
Lake, Miss.	Clay & Sand	41	61
(mailing address)	Sand	61	115

WELL LOCATION:
sec. 1 T~~1~~ N R 9 E
8 1/2 miles East of East
(distance) (direction) (nearest town)

WELL PURPOSE: Home
(home, irrigation, municipal, industrial)

WELL COMPLETION DATA:


- (1) diameter (inches) 2"
- (2) total depth (feet) 115 ft
- (3) static water level (feet) 15 below above top of ground.
- (4) casing 2" Galv. 115 ft (material) (depth)
2" if telescope see back. (size)
- (5) screen 10 ft (length) (depth to top)
2" Galv brass (size) (material)
- (6) pump 1 HP 2000 GPH (HP) (yield gpm)
Electric 220 Single Phase (type-power)
- (7) electric log 90 - (yes or no)
- (organization running log)
- (8) how well bottom plugged 2" Backwash Valve

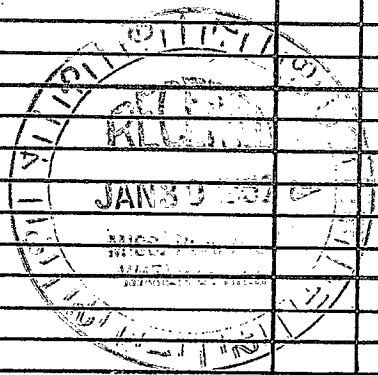

DRILLERS REMARKS:

If well telescopes please sketch and show depths.

GROUND LEVEL

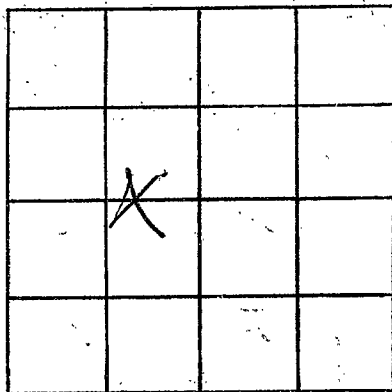

SECTION 1

Please indicate well location X.

ADDITIONAL INFORMATION

If more than one screen, show locations of each on sketch.