

**Scott Co**  
**M 47**  
**5-15-70**

**MISSISSIPPI**  
**BOARD OF WATER COMMISSIONERS**  
 416 North State Street  
 Jackson, Mississippi 39201

**WATER WELL DRILLERS LOG**

5/15 1970 Forest Drilling Scott  
 date well completed firm name county well located

LANDOWNER: Master Judge  
Nh-1  
Lake, Miss.  
 (mailing address)

WELL LOCATION: 026  
 sec. 2 T. 6 N R. 9 E  
5 miles N of Lake  
 (distance) (direction) (nearest town)

WELL PURPOSE: None  
 (home, irrigation, municipal, industrial)

- WELL COMPLETION DATA:
- (1) diameter (inches) 2"
  - (2) total depth (feet) 178'
  - (3) static water level (feet) 40' below above top of ground.
  - (4) casing steel, 168'  
 (material) (depth)  
2"  
 (size) if telescope see back.
  - (5) screen 10', 168'  
 (length) (depth to top)  
2", Stainless Steel  
 (size) (material)
  - (6) pump 2, 20 (AIR)  
 (HP) (yield gpm)  
Electric  
 (type power)
  - (7) electric log NO  
 (yes or no)
- (organization running log)
- (8) how well bottom plugged 2" Backwash Valve

description of formations encountered	from	to
Yellow clay	0	12
Blue clay	12	60
Blue clay + other silt	60	123
Silt + shale	123	134
Silt + other shale	134	144
Fine sand + shale	144	155
Silt + shale	155	163
Fine sand	163	186
Fine sand + other shale	186	198


DRILLERS REMARKS:

MAY 22 1970

MISS. BD. OF  
 WATER COMM.

If well telescopes please sketch and show depths.

GROUND LEVEL

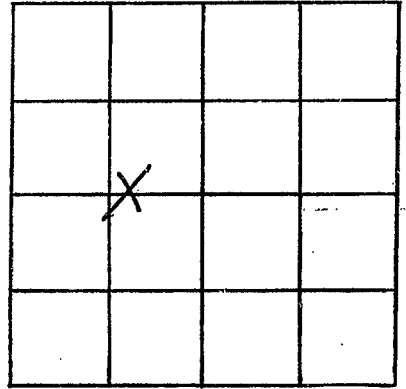

SECTION 2

Please indicate well location X.

ADDITIONAL INFORMATION

If more than one screen,  
show locations of each on sketch.