

MISSISSIPPI
BOARD OF WATER COMMISSIONERS
416 North State Street
Jackson, Mississippi 39201

CODED

WATER WELL DRILLERS LOG

SCOTT
M49
12-10-70

Dec 10 1970 date well completed
to Wilkerson firm name
Scott county well located

LANDOWNER: Lela Stunk

description of formations encountered

from to

Forest, Miss
(mailing address)

Red clay	0	20
Blue "	20	70
B. Brown clay	70	150
Sandy	150	180
W. Bearing sand	180	215

WELL LOCATION:

sec. 13 T-6 N R-1 E
3 miles East of Forest
(distance) (direction) (nearest town)

WELL PURPOSE: Home
(home, irrigation, municipal, industrial)

WELL COMPLETION DATA:

- diameter (inches) 2"
- total depth (feet) 215'
- static water level (feet) 76 below above top of ground.
- casing galv. 215' (material) (depth)
if telescope see back.
(size)
- screen 5' (length) (depth to top)
2" Braas (size) (material)
- pump 1 1/2 (HP) (yield gpm)
Elec. (type power)
- electric log (yes or no)
(organization running log)
- how well bottom plugged B.W.V.

CODED


DEC 28 1970

DRILLERS REMARKS:

MISS. BD. OF
WATER COMM.

If well telescopes please sketch and show depths.

GROUND LEVEL

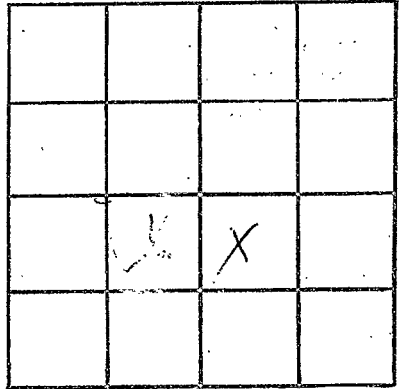

SECTION _____

Please indicate well location X.

ADDITIONAL INFORMATION

If more than one screen,
show locations of each on sketch.