

MISSISSIPPI  
BOARD OF WATER COMMISSIONERS  
416 North State Street  
Jackson, Mississippi 39201

**CODED**

WATER WELL DRILLERS LOG

SCOTT  
M50  
5-31-71

5-31 1971 Forest Drilling Service Scott  
date well completed firm name county well located

LANDOWNER: James R. Leach

Route 1, Lake  
(mailing address)

WELL LOCATION:

sec. 4 T. 6 N. R. 9 E.  
4 miles NW of LAKE  
(distance) (direction) (nearest town)

WELL PURPOSE: Home  
(home, irrigation, municipal, industrial)

WELL COMPLETION DATA:

- (1) diameter (inches) 2"
- (2) total depth (feet) 172 ft
- (3) static water level (feet) 54 below above top of ground.
- (4) casing Steel 166 ft.  
(material) (depth)
- 2" if telescope see back.  
(size)
- (5) screen 6' 166'  
(length) (depth to top)
- 2" Brass  
(size) (material)
- (6) pump 1 HP 6  
(HP) (yield gpm)
- Elec.  
(type power)
- (7) electric log no  
(yes or no)
- (organization running log)
- (8) how well bottom plugged 2"  
Backwash Valve

description of formations encountered	from	to
<u>Clay</u>	<u>0</u>	<u>10</u>
<u>clay + sand</u>	<u>10</u>	<u>20</u>
<u>Clay</u>	<u>20</u>	<u>61</u>
<u>clay &amp; murky sand</u>	<u>61</u>	<u>81</u>
<u>clay + fine sand</u>	<u>81</u>	<u>104</u>
<u>Clay</u>	<u>104</u>	<u>124</u>
<u>Clay &amp; str of clay</u>	<u>124</u>	<u>163</u>
<u>fine sand</u>	<u>163</u>	<u>172</u>

**CODED**


DRILLERS REMARKS:

JUN 2 1971

MISS. RD. OF  
WATER COMMISSIONERS

If well telescopes please sketch and show depths.

GROUND LEVEL

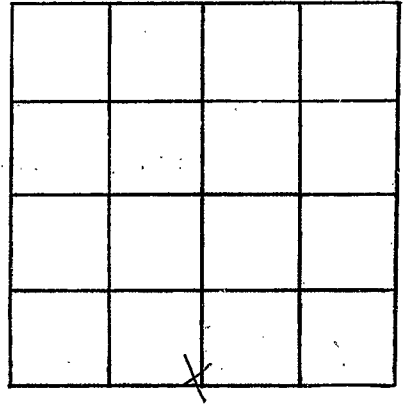

SECTION 4

Please indicate well location X.

ADDITIONAL INFORMATION

If more than one screen, show locations of each on sketch.