

MISSISSIPPI
BOARD OF WATER COMMISSIONERS
416 North State Street
Jackson, Mississippi 39201

CODED

WATER WELL DRILLERS LOG

SCOTT
M 51
5-31-71

5-31-19 date well completed
Forest Drilling Service - Scott firm name
county well located

LANDOWNER: H.C. McNamee

description of formations encountered

Route 1, Lake Miss

from 0 to 10

(mailing address)

Clay 10 20

WELL LOCATION:

Clay & sand 20 61

sec. 4 T 6 N R. 9 E

Clay + fine sand 61 81

4 miles NW of LAKE

fine sand 81 102

(distance) (direction) (nearest town)

fine sand 102 108

WELL PURPOSE:

Clay + fine sand 108 122

(home, irrigation, municipal, industrial)

fine sand + shales & clay 122 163

WELL COMPLETION DATA:

fine sand 163 168

(1) diameter (inches) 2"

fine sand + shales 168 200

(2) total depth (feet) 205 ft.

fine sand 200 205

(3) static water level (feet) 59 below above top of ground.

(4) casing Steel 163' (material) (depth)

CODED

(size) if telescope see back.

(5) screen 5' 163' (length) (depth to top)

2" Brass (size) (material)

(6) pump 3/4 6 (HP) (yield gpm)

Elect. (type power)

(7) electric log No (yes or no)

(organization running log)

(8) how well bottom plugged 2" Back wash valve


JUN 2 1971

DRILLERS REMARKS:

MISS. Bd. of WATER COMMISSIONERS

If well telescopes please sketch and show depths.

GROUND LEVEL

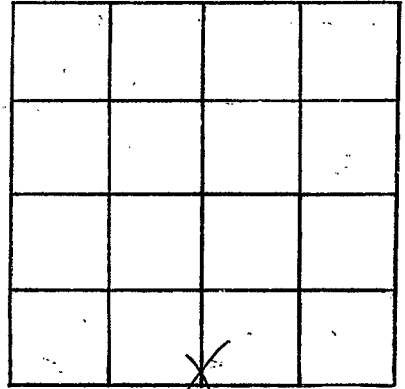

SECTION *H*

Please indicate well location X.

ADDITIONAL INFORMATION

If more than one screen,
show locations of each on sketch.