

SCOTT
M 53
10-15-71

g
ELOG #101

MISSISSIPPI
 BOARD OF WATER COMMISSIONERS
 416 North State Street
 Jackson, Mississippi 39201

WATER WELL DRILLERS LOG

CODED

10-15

1971

Singer Lays Central Div.

Scott

date well completed

firm name

county well located

LANDOWNER: *Steele-Ringgold*
Water Association, Inc
Forest, Miss.
 (mailing address)

WELL LOCATION:
 sec. 4 T 6 N R 9 E
3 NW 2nd
 (distance) **CODED** (direction) of (nearest town)

WELL PURPOSE: *Domestic*
 (home, irrigation, municipal, industrial)

- WELL COMPLETION DATA:
- (1) diameter (inches) 12"
 - (2) total depth (feet) 1007'
 - (3) static water level (feet) 142' below top of ground.
 - (4) casing Steel 925'
 (material) (depth)
12" x 67' 26"
 (size) if telescope see back.
 - (5) screen 70' 925'
 (length) (depth to top)
6" Stainless Steel
 (size) (material)
 - (6) pump 60 400
 (HP) (yield gpm)
Electric
 (type power)
 - (7) electric log yes
 (yes or no)
Miss. Geo. Survey
 (organization running log)
 - (8) how well bottom plugged Valve

description of formations encountered	from	to
<i>Sandy Red Clay</i>	0	20
<i>Blue Clay</i>	20	140
<i>Clay & Sand Strata</i>	140	220
<i>Clay</i>	220	309
<i>Rock</i>	309	310
<i>Soft Clay & Sand Strata</i>	310	340
<i>Sandy Clay</i>	340	394
<i>Hard Clay</i>	394	418
<i>Fine Sand & Clay Strata</i>	418	468
<i>Sand and Pyrite</i>	468	534
<i>Sandy Shale</i>	534	558
<i>Clay Hard</i>	558	700
<i>Rock</i>	700	702
<i>Shale and Sand Strata</i>	702	743
<i>Hard Clay & Limestone</i>	743	865
<i>Shale & Sand Strata</i>	865	945
<i>Fine Sand & Shale Strata</i>	945	1110
<i>Hard Shale</i>	1110	1218


CODED

OCT 20 1971

DRILLERS REMARKS:

If well telescopes please sketch and show depths.

GROUND LEVEL

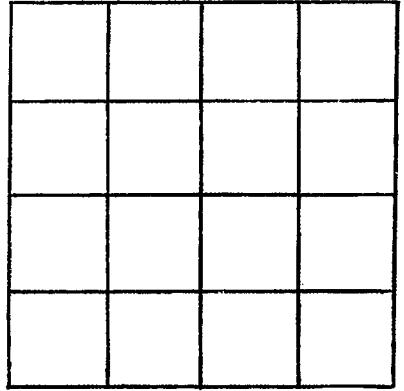

SECTION _____

Please indicate well location X.

ADDITIONAL INFORMATION

If more than one screen, show locations of each on sketch.