

SCOTT Co
 M54
 Log # 114

MISSISSIPPI
 BOARD OF WATER COMMISSIONERS
 416 North State Street
 Jackson, Mississippi 39201

CODED

WATER WELL DRILLERS LOG

5-1

19 73 Singer Lagoon Central Div

Scott

date well completed

firm name

county well located

LANDOWNER:
 Town of Lake, Miss.
 Lake, Miss.
 (mailing address)

WELL LOCATION:
 sec. 24 T 6 N R 9 E
 miles of (distance) (direction) (nearest town)

WELL PURPOSE: Municipal
 (home, irrigation, municipal, industrial)

- WELL COMPLETION DATA:
- diameter (inches) 8" x 6"
 - total depth (feet) 1121'
 - static water level (feet) 154' below top of ground.
 - casing Steel, 1040' (material) (depth)
 - screen 8" (size) if telescope see back. 50' (length) 1048' (depth to top) 1 1/2" (size) Stainless Steel (material)
 - pump 30 (HP) 250 (yield gpm) Electric (type power)
 - electric log yes (yes or no) Miss. Geo. Survey (organization running log)
 - how well bottom plugged Solid Bottom

description of formations encountered	from	to
Red Clay	0	4
White Gummy Clay	4	17
Blue Clay	17	85
Sandy Clay	85	138
Sand	138	262
Blue Clay	262	341
Rock	341	342
Blue Clay	342	358
Clay & Sandy Strata	358	474
Clay and Sand	474	572
Gummy Clay	572	691
Sandy Shale	691	724
Sand & Shale	724	771
Hard Shale & Sandy Strata	771	940
Sandy Shale	940	965
Sand	965	983
Sand & Shale	983	1048
Sand	1048	1110
Hard Shale	1110	1121


CODED

MAY 17 1973

DRILLERS REMARKS:

If well telescopes please sketch and show depths.

GROUND LEVEL

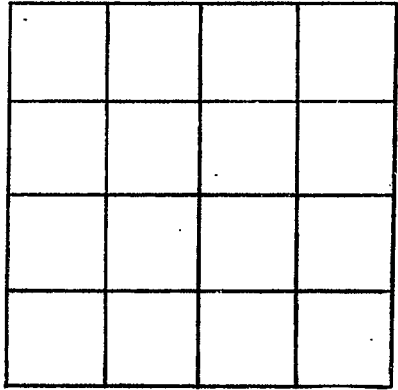

SECTION _____

Please indicate well location X.

ADDITIONAL INFORMATION

A series of horizontal lines providing space for additional information. The lines are evenly spaced and extend across the width of the form.

If more than one screen, show locations of each on sketch.