

SCOTT  
M 55  
7-23-73

MISSISSIPPI  
BOARD OF WATER COMMISSIONERS  
416 North State Street  
Jackson, Mississippi 39201

COPIED

WATER WELL DRILLERS LOG

6-18 1973 Walker and Drilling Scott  
date well completed firm name county well located

LANDOWNER: Mr. Billy McElorain  
Lake Miss  
(mailing address)

WELL LOCATION:  
sec. 25 T. 6N R. 9E  
1 1/4 miles South of Lake  
(distance) (direction) (nearest town)

WELL PURPOSE: home  
(home, irrigation, municipal, industrial)

- WELL COMPLETION DATA:
- (1) diameter (inches) 2
  - (2) total depth (feet) 231
  - (3) static water level (feet) 65 below top of ground.
  - (4) casing Galv, 231,  
(material) (depth)  
2 If telescope see back.  
(size)
  - (5) screen 5, 231  
(length) (depth to top)  
2", 3.5" Steel  
(size) (material)
  - (6) pump 2, 13  
(HP) (yield gpm)  
Elec - Air  
(type power)
  - (7) electric log NO  
(yes or no)  
(organization running log)
  - (8) how well bottom plugged 2" BWW

| description of formations encountered | from       | to         |
|---------------------------------------|------------|------------|
| <u>yellow clay</u>                    | <u>0</u>   | <u>15</u>  |
| <u>blue</u>                           | <u>15</u>  | <u>128</u> |
| <u>Red</u>                            | <u>128</u> | <u>131</u> |
| <u>blue clay</u>                      | <u>131</u> | <u>170</u> |
| <u>brandy</u>                         | <u>170</u> | <u>198</u> |
| <u>Sand</u>                           | <u>198</u> | <u>231</u> |


COPIED

10 1973

DRILLERS REMARKS:

If well telescopes please sketch and show depths.

GROUND LEVEL

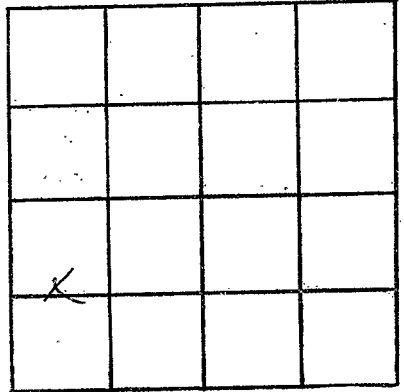

SECTION 25

Please indicate well location X.

ADDITIONAL INFORMATION

If more than one screen,  
show locations of each on sketch.