

MISSISSIPPI DEPARTMENT OF NATURAL RESOURCES

Bureau of Land and Water Resources

Southport Mall

P.O. Box 10631

Jackson, Mississippi 39209

WATER WELL DRILLERS LOG

CODED

Scott
M 59

Griner Drilling Service, Inc.

Scott

1-25-86 date well completed

Griner Drilling Service, Inc. firm name


Scott county well located

LANDOWNER:	description of formations encountered	from	to
(mailing address)			
Exeter Drilling 144 Elk Place Suite 1502 New Orleans, La. 70112	CLAY	0	294
WELL LOCATION: 600' N & 240' W sec. 34 T 60 R 9 E of NO 1 Freeman's Lake, WSE/CR Gray (distance) miles (direction) of (nearest town)	FINE SAND	294	370
WELL PURPOSE: oilfield supply (home, irrigation, municipal, industrial)	sand, good course little streaked	370	420
WELL COMPLETION DATA:	streaked clay	420	490
(1) diameter (inches) 3"	CODED		
(2) total depth (feet) 490'			
(3) static water level (feet) 80' below top of ground.			
(4) casing Steel, 420' (material), (depth) 3" (size) if telescope see back.			
(5) screen 42' (length), 378' (depth to top) 3" (size), perforated (material)			
(6) pump NO (HP), 75 (yield gpm) AC (type power)			
(7) electric log (yes or no)			
(organization running log)			
(8) how well bottom plugged orange peel			
DRILLERS REMARKS:			

RECEIVED
FEB 18 1986
Department of Natural Resources
Bureau of Land and Water Resources

If well telescopes please sketch and show depths.

GROUND LEVEL

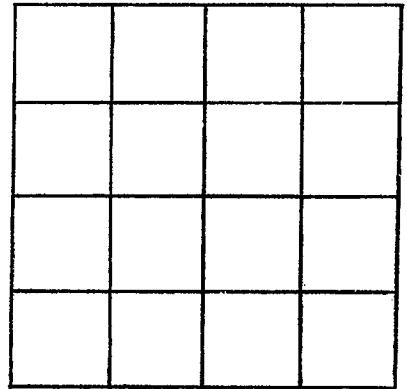

SECTION _____

Please indicate well location X.

ADDITIONAL INFORMATION

If more than one screen, show locations of each on sketch.