

MISSISSIPPI DEPARTMENT OF NATURAL RESOURCES
 Bureau of Land and Water Resources
 Southport Mall
 P.O. Box 10631
 Jackson, Mississippi 39209
WATER WELL DRILLERS LOG

CODED

SCOTT
 M 60

Sept. 1987 Greiner Drilling Service SCOTT
 date well completed firm name county well located

LANDOWNER: TOWN OF LAKE, WELL NO. 2
 (mailing address)
 WELL LOCATION: SEA SW 1/4 NE 1/4
 sec. 24 T. 6 N. R. 9 E. S. 5 W.
 miles _____ of _____
 (distance) (direction) (nearest town)

description of formations encountered	from	to
TOP SOIL	0	2
CLAY	2	70
SAND + CLAY STREAMS	70	140
SAND	140	250
CLAY	250	412
SAND + CLAY STREAMS	412	500
SAND	500	560
CLAY	560	700
SANDY CLAY	700	734
CLAY	734	970
SAND	970	990
CLAY, FINE SAND STRS	990	1044
SAND	1044	1094
CLAY + SAND STREAMS	1094	1123

WELL PURPOSE:
 (home, irrigation, municipal, industrial)

- WELL COMPLETION DATA:
- diameter (inches) 12 3/4
 - total depth (feet) 1123
 - static water level (feet) 124.35 below top of ground.
 - casing STEEL, 1044
 (material) (depth)
12 3/4 if telescope see back.
 (size)
 - screen 42, 1054
 (length) (depth to top)
6, 304.55 (.016)
 (size) (material)
 - pump 40, 250
 (HP) (yield gpm)
ELECT.
 (type power)
 - electric log YES
 (yes or no)
GREINER DRILLING SERVICE
 (organization running log)
 - how well bottom plugged BACK WASH
VALVE + CONCRETE

DRILLERS REMARKS:

CODED


RECEIVED

SEP 08 1987

Department of Natural Resources
 Bureau of Land & Water Resources

If well telescopes please
sketch and show depths.

GROUND LEVEL

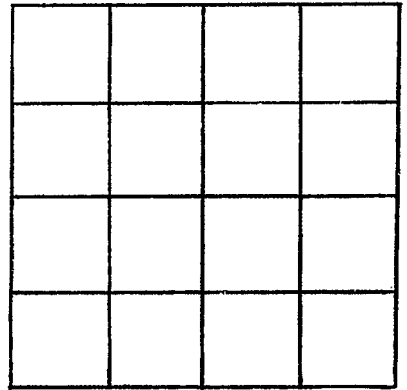

SECTION _____

Please indicate well location X.

ADDITIONAL INFORMATION

If more than one screen,
show locations of each on sketch.