

E 106
457

3/ N 2
7-25-62

WATER WELL DRILLERS LOG

FOREST DRILLING SERVICE

Date: 7/25, 1962, Driller: 231 Highway 35 North, County: Scott, MISSISSIPPI

(1) Owner of Land: Joe Brown
(Name)
Myton, Miss.
(Address)

(2) Location: SW 1/4, NW 1/4, Sec. 13 S.W. 1/4
T. R.
6 miles South of Myton
(distance) (direction) (Nearest Town)

(3) Topography: X (Hilly) (Flat) (Level)

(4) Purpose of Well: Chicken House
(Domestic Irrigation
Municipal, Industrial, Other)

| Description & Color of Materials Sand, Clay, Red Clay, Shell, etc. | Thick- ness Feet | Depth Feet |
|---|------------------------|---------------|
| Clay + Red sand | 0 | 12 |
| Clay | | 32 |
| Clay + Mucky sand | | 42 |
| Blue Clay | | 122 |
| Shale | | 337 |
| Shale + lime rock | | 367 |
| Shale | | 387 |
| Shale + rock | | 397 |
| Shale (sandy) | | 407 |
| Shale | | 445 |
| Shale + 1/2 lbs Mucky sand | 20 | 465 |
| 1/2 lbs fine sand + shale | 20 | 485 |
| 1/2 lbs shale + mucky sand | 10 | 495 |
| Shale | | |
| Fine sand | | |
| Shale | | 577 |
| Fine sand | | 580 |
| Shale + 1/2 lbs fine sand | | 620 |
| mucky sand | | 630 |
| Shale + 1/2 lbs fine sand | | 644 |
| Fine sand | | 664 |
| Shale | | 700 |
| Shale + 1/2 lbs. rock | | 727 |
| Shale | | 735 |
| Rock | | 737 |
| Shale | | 764 |
| rock | | 767 |
| Shale | | 772 |
| Rock | | 775 |
| Shale | | 784 |
| Rock | | 790 |
| hard shale + rock | | 797 |

Information upon completion of well:

(1) Diameter 2" inches.

(2) Total Depth 903 feet.

(3) Water Level 200 feet below top of ground.

(4) Cased to 888, Size 2"


(5) Screen: Size 2", Length 15ft.

(6) Were any formations sealed against pollution?
_____ yes, X no.

If YES depth of formation _____

Why _____

Drillers Remarks _____

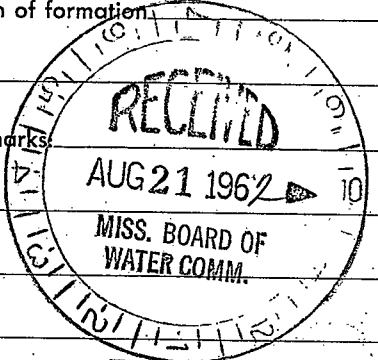

(over)

Well No

(Use Back Side)

| | | |
|-------|---|-------------------------|
| 997 - | | Shale + Ark. Coal |
| 847 | - | Soft shale + Musky bank |
| 827 | - | fine sand + shells |
| 837 | - | fine sand |
| 847 | - | fine sand + Ark. shale |
| 862 | - | fine sand |
| 872 | - | fine sand + Ark. sand |
| 876 | - | Shale + Ark. sand |
| 896 | - | fine sand |
| 903 | - | fine sand |