

MAILED COPY 4-11-68

SCOTT
NA
3-68

MISSISSIPPI
BOARD OF WATER COMMISSIONERS
416 North State Street
Jackson, Mississippi 39201

WATER WELL DRILLERS LOG

USGS
March

1968 Robert E. Raliff Co.

Scott

date well completed

firm name

county well located

LANDOWNER:

Homestead Water Assn
Scott Co, Miss.
(mailing address)

description of formations encountered

from to

WELL LOCATION:


sec. 21 T. 5(N) R. 6(E)
S W
8 miles So. of Merton
(distance) (direction) (nearest town)

Sand	0	30
Sand + gravel	30	90
Sand + Shale	90	122
Sand	122	279
Quartz	279	488
Shale	488	550
Shale + Sand	550	793
Sand	793	846
Shale	846	960
Sand + Shale	960	1232
Sand	1232	1242
Shale	1242	1250
Sand	1250	1320
Shale	1320	1380

WELL PURPOSE: A rural well system
(home, irrigation, municipal, industrial)

WELL COMPLETION DATA:

- (1) diameter (inches) 10 X 6
- (2) total depth (feet) 1320
- (3) static water level (feet) 360 below top of ground.
- (4) casing Bl. steel, 1,250 (material) (depth)
10" (size) If telescope see back.
- (5) screen 72, 1,250 (length) (depth to top)
6" (size) stainless steel (material)
- (6) pump 600, 30.0 (HP) (yield gpm)
electric (type power)
- (7) electric log eyes (yes or no)
U.S.G.S. (organization running log)
- (8) how well bottom plugged BPU

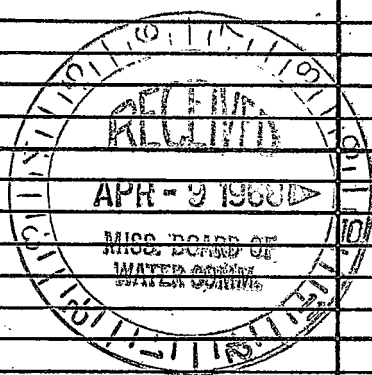


DRILLERS REMARKS:

2

If well telescopes please sketch and show depths.

GROUND LEVEL

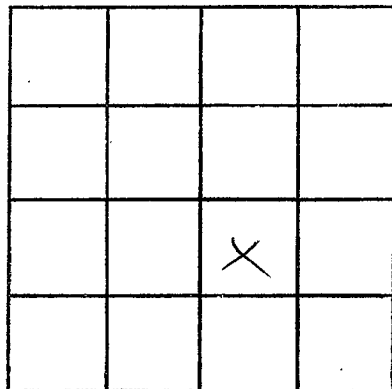

SECTION 21

Please indicate well location X.

ADDITIONAL INFORMATION

If more than one screen, show locations of each on sketch.