

SCOTT MISSISSIPPI BOARD OF WATER COMMISSIONERS

WATER WELL DRILLERS LOG

Date: 5/5, 1966, Driller: Forest Drilling County Scott

(1) Owner of Land: Live Creek Church
 (Name)
Merton Driss
 (Address)

(2) Location: 1/4, 1/4, Sec. 5 T. R
 (distance) (direction) (Nearest Town)

(3) Topography: _____
 (Hilly) (Flat) (Level)

(4) Purpose of Well: Church
 (Domestic Irrigation
 Municipal, Industrial, Other)

Description & Color of Materials Sand, Clay, Red Clay, Shell, etc.	Thick- ness Feet	Depth Feet
Brown Clay	0	28
Blue Clay		182
Clay		275
Spl + Sls lime rock		340
Amber Shell		350
Shale		377
Mucky Sand		390
Soft shale + mky sand		400
Soft shale		440
Shale		530
Fine sand + clay		550
Shale + mky sand		557
Fine sand		565
Clay		567
Fine sand		580

Information upon completion of well:

(1) Diameter 2 inches.

(2) Total Depth 577 feet.

(3) Water Level 158 feet below top of ground.

(4) Cased to 567, Size 2"


(5) Screen: Size 2", Length 10ft

(6) Were any formations sealed against pollution?
 _____ yes, no.

If YES depth of formation _____

Why _____

Drillers Remarks:
Ho

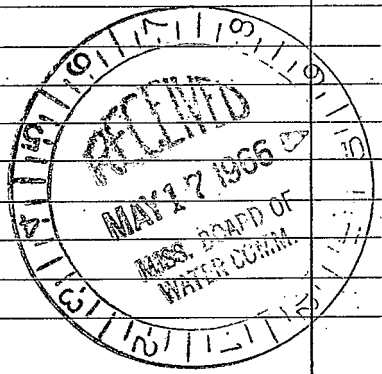

(Use Back Side)

Well No.

