

SCOTT

WATER WELL DRILLERS LOG

6 N 1
5-31-62
5/31

Date: 5/31, 1962, Driller: FOREST DRILLING SERVICE, Scott

231 Highway 35 North
FOREST, MISSISSIPPI

(1) Owner of Land: Curtis Davis
(Name)
Rt. Merton, Miss
(Address)

(2) Location: 1/4, 1/4, Sec. 21 ^{SW 6E} T. R.
7 miles South of Merton
(distance) (direction) (Nearest Town)

(3) Topography: (Hilly) (Flat) (Level)

(4) Purpose of Well: Chickens
(Domestic Irrigation
Municipal, Industrial, Other)

Description & Color of Materials Sand, Clay, Red Clay, Shell, etc.	Thick- ness Feet	Depth Feet
Brown Clay	0	22
Clay + shs Clay	22	42
Blue Clay	58	100
fine sand	07	102
shls + shs rock	60	342
shale	45	387
shls + clay	70	417
shls + shs fine sand	10	427
shls + shs sand	56	471
shale	30	501
Clay + mucky sand	20	521
Fine sand	10	531
shale	25	556
rock	1	557
shale	37	580
Fine sand	8	588
shale	75	603
shls + shs sand	20	623
shale	60	683
shls + shs. rock	20	703
hard shale + rock	70	773
shale	09	782
shls + shs sand	10	792
fine sand + shs clay	10	812
shale	74	886
Fine sand	6	892
clay + shs sand	20	912
shale	52	964
Fine sand	26	990

Information upon completion of well:

(1) Diameter 2" inches.

(2) Total Depth 990 feet.

(3) Water Level 185 feet below top of ground.

(4) Cased to 970, Size 2"


(5) Screen: Size 2", Length 20ft.

(6) Were any formations sealed against pollution?
_____ yes, no.

If YES depth of formation _____

Why _____

Drillers Remarks: _____

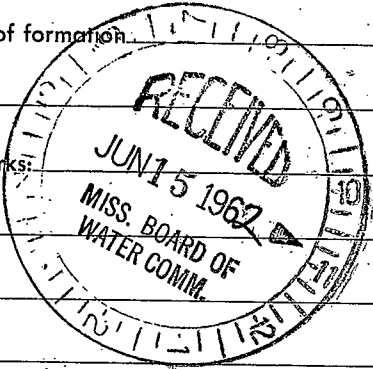

(Use Back Side)

Well No.

1870
1871
1872

1887