

6 N 10  
6-24-64

WATER WELL DRILLERS LOG

Date: 6/24, 1964, Driller: Frank D. Williams County: Scott  
(Name)

(1) Owner of Land: Jimmy Carter  
(Name)  
Del. Hatchie, Miss.  
(Address)

(2) Location: 1/4, 1/4, Sec. 20 T. 2 R. 1  
12 miles So. East of Del. Hatchie  
(distance) (direction) (Nearest Town)

(3) Topography: Flat  
(Hilly) (Flat) (Level)

(4) Purpose of Well: Home  
(Domestic Irrigation  
Municipal, Industrial, Other)

Description & Color of Materials Sand, Clay, Red Clay, Shell, etc.	Thick- ness Feet	Depth Feet
<u>Silt &amp; chky clay</u>		<u>16</u>
<u>B. Clay</u>		<u>38</u>
<u>Clay Lignit &amp; Silt</u>		<u>61</u>
<u>B. Clay</u>		<u>389</u>
<u>Shale &amp; Alth. Stone</u>		<u>485</u>
<u>Silt &amp; sh. Sand</u>		<u>475</u>
<u>Shale &amp; silt</u>		<u>555</u>
<u>Shale &amp; silt</u>		<u>576</u>
<u>Shale</u>		<u>680</u>
<u>Shale &amp; silt</u>		<u>701</u>
<u>Shale</u>		<u>712</u>
<u>Shale</u>		<u>785</u>
<u>Shale &amp; silt</u>		<u>861</u>
<u>Rock</u>		<u>865</u>
<u>Shale</u>		<u>869</u>
<u>Shale &amp; silt</u>		<u>883</u>
<u>7. Sand &amp; silt</u>		<u>890</u>
<u>Shale</u>		<u>915</u>

Information upon completion of well:

(1) Diameter 2 inches.

(2) Total Depth 915 feet.

(3) Water Level 209 feet below top of ground.

(4) Cased to 900, Size 2"


(5) Screen: Size 2", Length NFL

(6) Were any formations sealed against pollution?  
 yes,  no.

If YES depth of formation \_\_\_\_\_

Why \_\_\_\_\_

Drillers Remarks: \_\_\_\_\_

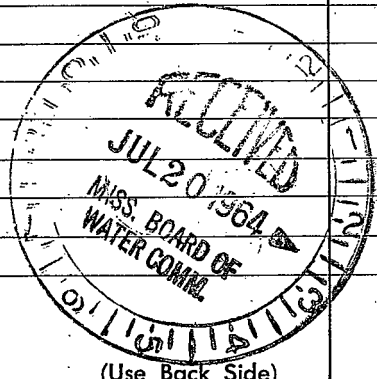

(Use Back Side)

Well No.

