

SCOTT MISSISSIPPI BOARD OF WATER COMMISSIONERS

N 12  
11-65

WATER WELL DRILLERS LOG

Date: Nov., 1965, Driller: W. G. Butler County Scott  
(Name)

(1) Owner of Land: Joe Brown  
(Name)  
Morton  
(Address)

(2) Location: 1/4, 1/4, Sec. 14 T5R6E  
(distance) (direction) (Nearest Town)

(3) Topography:  (Hilly)  (Flat)  (Level)

(4) Purpose of Well: Domestic  
(Domestic Irrigation  
Municipal, Industrial, Other)

Description & Color of Materials Sand, Clay, Red Clay, Shell, etc.	Thick- ness Feet	Depth Feet
Red Clay	1-	10
Sand + Chalk	10-	30
Red Chalk	30	40
Chalk + Shell	40	30.3
Rock + Chalk	30.3	31.3
Chalk + Shell	31.3	32.3
Blue Shell Rock + Shell	32.3	33.3
Sand + Shell	33.3	36.3
Chalk + Sand	36.3	37.3
Sand	37.3	38.3
Sand + Chalk	38.3	39.3
Chalk + Lignite	39.3	40.3
Sand	40.3	41.3
Sand	41.3	42.3
Lignite + Sand	42.3	43.3
Sand + Chalk	43.3	596

Information upon completion of well:

(1) Diameter 2" inches.

(2) Total Depth 596 feet.

(3) Water Level \_\_\_\_\_ feet below top of ground.

(4) Cased to 576, Size 2"


(5) Screen: Size 2", Length 20'

(6) Were any formations sealed against pollution?  
\_\_\_\_\_ yes, \_\_\_\_\_ no.

If YES depth of formation \_\_\_\_\_

Why \_\_\_\_\_

Drillers Remarks: \_\_\_\_\_

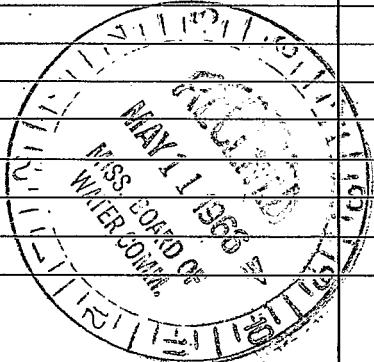

(Use Back Side)

Well No.

Handwritten text, likely bleed-through from the reverse side of the page. The text is extremely faint and illegible due to the quality of the scan.