

44
12
73 2

MISSISSIPPI
BOARD OF WATER COMMISSIONERS
416 North State Street
Jackson, Mississippi 39201

WATER WELL DRILLERS LOG

SCOTT
N 14
3-68

March 1968 Wilkerson Drilling SCOTT
date well completed firm name county well located

LANDOWNER: Buddy Taylor

description of formations encountered	from	to
Clay + sand	0	60
Blue clay	60	205
brown shale	205	280
brown sand	280	305
Shale + sand	305	340
Shale + rock	340	380
Fine sand	380	444
Shale + sand	444	580

481 S.
Morton Miss
(mailing address)

WELL LOCATION:
sec. 32 T. 5 N. R. 6 E.
S. W.
4 miles S of Morton
(distance) (direction) (nearest town)

WELL PURPOSE: home
(home, irrigation, municipal, industrial)


- WELL COMPLETION DATA:
- (1) diameter (inches) 2"
 - (2) total depth (feet) 444
 - (3) static water level (feet) 140 below above top of ground.
 - (4) casing Galv, 432,
(material) (depth),
2"
(size) if telescope see back.
 - (5) screen 12, 432
(length) (depth to top)
2", brass
(size) (material)
 - (6) pump 5, 13
(HP) (yield gpm)
elec
(type power)
 - (7) electric log No
(yes or no)
(organization running log)
 - (8) how well bottom plugged 2-2" ball

DRILLERS REMARKS:

MAY 9 1968
MISS. BD. OF
WATER COMM.

If well telescopes please sketch and show depths.

GROUND LEVEL

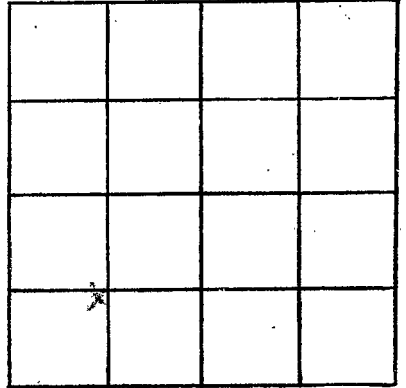

SECTION 32

Please indicate well location X.

ADDITIONAL INFORMATION

If more than one screen, show locations of each on sketch.