

SCOTT  
 N CODED  
 8-68

MISSISSIPPI  
 BOARD OF WATER COMMISSIONERS  
 416 North State Street  
 Jackson, Mississippi 39201

WATER WELL DRILLERS LOG

August 1968 Wilkerson Drilling SCOTT  
 date/well completed firm name county well located

LANDOWNER: Mr James Peritt

Monton Miss

(mailing address)

WELL LOCATION:

sec. 2 T. 5 N R. 16 E S W  
 4 miles South of Monton  
 (distance) (direction) (nearest town)

WELL PURPOSE: home  
 (home, irrigation, municipal, industrial)

WELL COMPLETION DATA:

- (1) diameter (inches) 2
- (2) total depth (feet) 531
- (3) static water level (feet) 189 below top of ground.
- (4) casing GALV, 525, (material) (depth)  
 if telescope see back. (size)
- (5) screen 6, 525 (length) (depth to top)  
 2, BRASS (size) (material)
- (6) pump 2, 6 (HP) (yield gpm)  
 Elec (type power)
- (7) electric log No (yes or no)

(organization running log)

(8) how well bottom plugged 2" b.w.l.

DRILLERS REMARKS:

description of formations encountered	from	to
yellow clay	0	40
blue "	40	250
Rock	250	255
blue clay	255	350
" shale	350	390
Rock	390	394
brown shale	394	470
SAND	470	530


CODED

AUG 16 1968

MISS. BD. OF  
 WATER COMM.

If well telescopes please  
sketch and show depths.

GROUND LEVEL

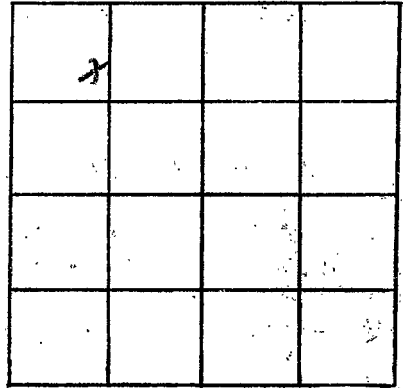

SECTION 2

Please indicate well location X.

ADDITIONAL INFORMATION

If more than one screen,  
show locations of each on sketch.