

SCOTT
N16
4-9-70

MISSISSIPPI
BOARD OF WATER COMMISSIONERS
416 North State Street
Jackson, Mississippi 39201

CODED

WATER WELL DRILLERS LOG

4-9 1970 Comms Drilling Service Scott
date well completed firm name county well located

LANDOWNER: J & B Reeves
Morton R # 4
Miss
(mailing address)

WELL LOCATION:
sec. 23 T. 5 N. R. 6 E
6 miles S of MORTON
(distance) (direction) (nearest town)

WELL PURPOSE: Home
(home, irrigation, municipal, industrial)

WELL COMPLETION DATA:

- (1) diameter (inches) 2"
- (2) total depth (feet) 640
- (3) static water level (feet) 159 below above top of ground.
- (4) casing Steel, 630,
(material) (depth)
 if telescope see back.
(size)
- (5) screen 16, 630
(length) (depth to top)
2", 5/8
(size) (material)
- (6) pump 2 HP 250 GPM
(HP) (yield gpm)
Electric
(type power)
- (7) electric log No.
(yes or no)

(organization running log)
- (8) how well bottom plugged

description of formations encountered	from	to
Clay		
Clay	0	22
Sand & Clay	20	48
Sand	48	54
Clay	54	108
Rock & Shell	108	112
Clay	112	409
Clay & Fill		
Sand & Ledges	409	426
Clay	426	440
Sand & Clay	440	600
Fill Sand	600	620
Fine Sand	620	640

CODED


AUG 5 1970

MISS. BD. OF
WATER COMM.

DRILLERS REMARKS:
None

If well telescopes please sketch and show depths.

GROUND LEVEL

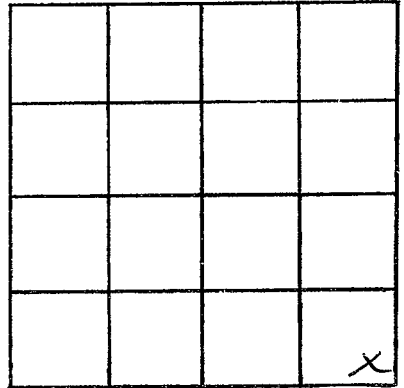

SECTION 23

Please indicate well location X.

ADDITIONAL INFORMATION

If more than one screen,
show locations of each on sketch.