

CODED

WATER WELL DRILLERS LOG

SCOTT
N 17
4-19-65

Date: 4/19, 1965, Driller: Forest Drilling County Scott
(Name)

(1) Owner of Land: E. L. Cooper
(Name)
Rt 2 Delahatchie, Miss.
(Address) 29 5-6

(2) Location: 1/4, 1/4, Sec. T R
_____ miles _____ of _____
(distance) (direction) (Nearest Town)

(3) Topography: _____
(Hilly) (Flat) (Level)

(4) Purpose of Well: Home
(Domestic Irrigation
Municipal, Industrial, Other)

Description & Color of Materials Sand, Clay, Red Clay, Shell, etc.	Thick- ness Feet	Depth Feet
<u>Brown Clay</u>		<u>22</u>
<u>Brown Clay + Sand</u>		<u>35</u>
<u>Blue Clay</u>		<u>42</u>
<u>Clay + Sh. Rock</u>		<u>52</u>
<u>Clay</u>		<u>92</u>
<u>Clay + Sh. Fin Sand</u>		<u>102</u>
<u>Clay</u>		<u>112</u>
<u>Clay + Sh. Sand</u>		<u>122</u>
<u>Clay</u>		<u>146</u>
<u>Fin Sand + Sh. Clay</u>		<u>152</u>
<u>Fine Sand</u>		<u>159</u>

Information upon completion of well:

(1) Diameter 2 inches.

(2) Total Depth 159 feet.

(3) Water Level 78 feet below top of ground.

(4) Cased to 149, Size 2"

(5) Screen: Size 2", Length 10 ft.


(6) Were any formations sealed against pollution?
_____ yes, no.

If YES depth of formation _____

Why _____

Drillers Remarks: _____

CODED

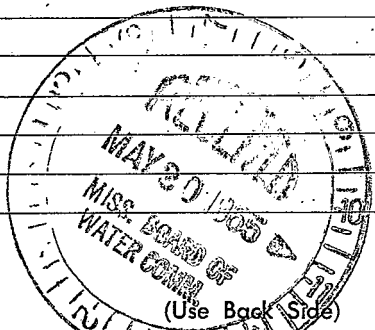

Well No.

