

SCOTT
N 18
8-24-73

MISSISSIPPI
BOARD OF WATER COMMISSIONERS
416 North State Street
Jackson, Mississippi 39201

CODED

WATER WELL DRILLERS LOG

8-24
date well completed

1973

Wilkeson Drilling
firm name

Scott
county well located

LANDOWNER:
Mt. Roland Myrick
Menton, MISS
(mailing address)

description of formations encountered	from	to
Sand + Clay - Red	0	50
Clay - Blue	50	280
Fine Sand	280	290
Clay - Blue	290	420
Reddish clay	420	460
SAND	460	593

WELL LOCATION:
sec. 36 T-5(N) R-6(E)
8 miles S.W. of Pilaski
(distance) (direction) (nearest town)

WELL PURPOSE: home
(home, irrigation, municipal, industrial)

- WELL COMPLETION DATA:
- (1) diameter (inches) 2
 - (2) total depth (feet) 593'
 - (3) static water level (feet) 136 below top of ground.
 - (4) casing GALV, 588', (material), (depth)
if telescope see back.
 - (5) screen 5, 593 (length), (depth to top)
2, STAINLESS (size), (material)
 - (6) pump 3 HP, 9 (HP), (yield gpm)
ELEC. (type power)
 - (7) electric log NO (yes or no)
(organization running log)
 - (8) how well bottom plugged 2" BU U

CODED


GED O.A. WEA

DRILLERS REMARKS:

MISSISSIPPI
BOARD OF WATER COMMISSIONERS
WATER QUALITY

If well telescopes please sketch and show depths.

GROUND LEVEL

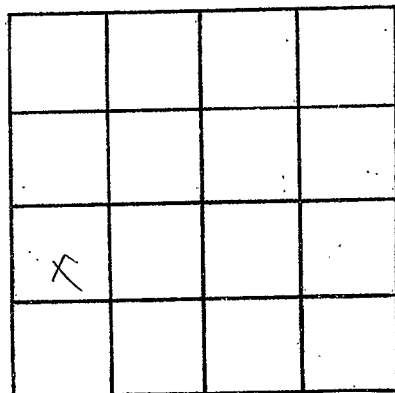

SECTION 36

Please indicate well location X.

ADDITIONAL INFORMATION

If more than one screen, show locations of each on sketch.