

SCOTT  
N 20  
5/80  
E 133

MISSISSIPPI  
BOARD OF WATER COMMISSIONERS  
416 North State Street  
Jackson, Mississippi 39201

CODED

WATER WELL DRILLERS LOG

PRINER DRILLING SERVICE SCOTT

19 date well completed

firm name

county well located

LANDOWNER: HOMESTEAD WATER ASSOCIATION, well No. 2  
(mailing address)

WELL LOCATION: N 1/4 N 1/4 NW 1/4  
sec. 21 T 5 N R 6 E W  
(distance) miles (direction) of (nearest town)

WELL PURPOSE: (home, irrigation, municipal, industrial)

WELL COMPLETION DATA:  
(1) diameter (inches) 10 3/4  
(2) total depth (feet) 1322  
(3) static water level (feet) 400 below above top of ground.  
(4) casing steel, 1252' (material) (depth)  
10 3/4 (size) if telescope see back.  
(5) screen 60, 1262' (length) (depth to top)  
6", 304 S.S. (0.016) screen (size) (material)  
(6) pump 40, 400 (HP) (yield gpm)  
Elect. (type power)  
(7) electric log Yes (yes or no)  
MGS (organization running log)  
(8) how well bottom plugged Back  
WASH UNPLUG

description of formations encountered	from	to
TOP SOIL	0	3
CLAY, RED + SAND	3	20
SANDY CLAY	20	32
SAND	32	106
CLAY	106	150
SAND	150	182
CLAY + ROCKS	182	270
SAND, FINE	270	341
CLAY + ROCKS	341	494
SAND, FINE	494	1092
CLAY	1092	1220
SAND + CLAY STRATIG	1220	1232
SAND	1232	1330
CLAY + ROCKS, HARD	1330	1382

CODED


DEPT. OF NATURAL RESOURCES  
BUREAU OF LAND & WATER RESOURCES

JUN 25 1980  
RECEIVED

DRILLERS REMARKS:

If well telescopes please sketch and show depths.

GROUND LEVEL

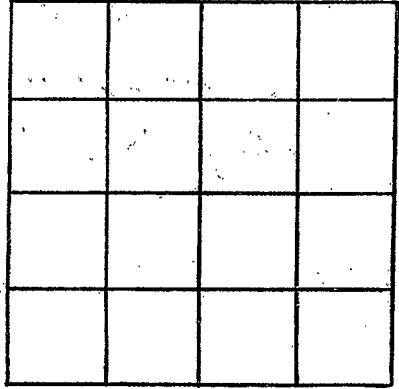

SECTION \_\_\_\_\_

Please indicate well location X.

ADDITIONAL INFORMATION

If more than one screen, show locations of each on sketch.