

MISSISSIPPI DEPARTMENT OF NATURAL RESOURCES

Bureau of Land and Water Resources

Southport Mall

P.O. Box 10631

Jackson, Mississippi 39209 CODED

WATER WELL DRILLERS LOG

SCOTT  
N 21  
11/30/83

11-30-83  
date well completed

Griner Drilling  
Service, Inc.  
firm name

Scott  
county well located


LANDOWNER:	description of formations encountered	from	to
Stone Petroleum Corp. P.O. Box 52382 Lafayette, La. 70505 (mailing address)			
WELL LOCATION: 1850'S + 1106'E Spc. 10-T-5 R. 6 NW/40 No. 1 Rosebaum 5 miles South of Morton (distance) (direction) (nearest town)	chalk, rock	21	399
WELL PURPOSE: Outfield supply (home, irrigation, municipal, industrial)	fine sand	399	441
WELL COMPLETION DATA:	chalk streaks	441	609
(1) diameter (inches) 4"	sand	609	651
(2) total depth (feet) 651'			
(3) static water level (feet) 150' below top of ground.			
(4) casing steel 651' (material) (depth) 4" (size) if telescope see back.			
(5) screen 42' 609' (length) (depth to top) 4" perforated (size) (material)			
(6) pump — 80 (HP) (yield gpm) AC (type power)			
(7) electric log — (yes or no) (organization running log)			
(8) how well bottom plugged orange peel			
DRILLERS REMARKS:			

CODED

Rec'd  
Dec 9/83  
JH

If well telescopes please  
sketch and show depths.

GROUND LEVEL

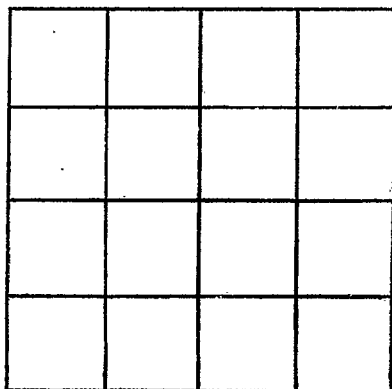

SECTION \_\_\_\_\_

Please indicate well location X.

ADDITIONAL INFORMATION

If more than one screen,  
show locations of each on sketch.