

Bureau of Land and Water Resources

Southport Mall

P.O. Box 10631

Jackson, Mississippi 39209

CODED

WATER WELL DRILLERS LOG

SCOTT
N 22

Griner Drilling Service, INC.

SCOTT

10-15-84
date well completed

Griner Drilling Service, INC.
firm name

Scott
county well located

LANDOWNER:
Stone Petroleum Corp.
P.O. Box 52382
Lafayette, La. 70505
(mailing address)

description of formations encountered	from	to
chalk	0	103
rock	103	105

WELL LOCATION: *575° 54' 42" E*
sec. *15* T. *50* N. R. *6* E of
No. 1 Stuart miles *Morton* of
(distance) (direction) (nearest town)

description of formations encountered	from	to
chalk	105	376
sand	376	378

WELL PURPOSE: *oil field supply*
(home, irrigation, municipal, industrial)

description of formations encountered	from	to
chalk, shell	378	423
sand	423	441

WELL COMPLETION DATA:

(1) diameter (inches) *3"*

(2) total depth (feet) *609'*

(3) static water level (feet) *185'* ^{below} _{above} top of ground.

(4) casing *steel*, *588'*
(material) (depth)

3"
(size) if telescope see back.

(5) screen *42'*, *546'*
(length) (depth to top)

3", *perforated*
(size) (material)

(6) pump *-*, *75*
(HP) (yield gpm)

AC
(type power)

(7) electric log (yes) (no)

description of formations encountered	from	to
chalk	441	509
sand	509	588
sand, lignite	588	609

(organization running log)

DEPT. OF NATURAL RESOURCES
BUREAU OF LAND & WATER RESOURCES

OCT 22 1984


(8) how well bottom plugged *orange peel*

RECEIVED

DRILLERS REMARKS:

If well telescopes please
sketch and show depths.

GROUND LEVEL

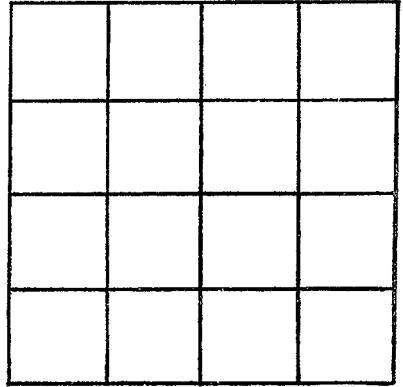

SECTION _____

Please indicate well location X.

ADDITIONAL INFORMATION

If more than one screen,
show locations of each on sketch.