

State Well Report

Part 1

Mississippi Department of Environmental Quality
Office of Land and Water Resources
P.O. Box 10631
Jackson, MS 39289-0631
(601)961-5210
(601)354-6938 (fax)

For Office Use Only:

Aquifer: _____
Well #: N-27
L. S. Elevation: _____
E-log #: _____

County: Scott
Permit #: _____
Driller: Gary Rayborn
Date drilling completed: 1-8-07

State Law requires that this report be prepared by the driller in detail and filed with the Department within 30 days of completion of drilling of the well.

Well Owner Information	Well Location
Owner Name: <u>D+D Drilling, Inc.</u>	Latitude: _____ Longitude: _____
Mailing Address: <u>P.O. Box 1634</u>	Method of Lat/Long (circle one): Conventional Survey, USGS quad, Hand-held GPS, Survey-grade GPS
<u>Ferriday, LA 71343</u>	____ 1/4 ____ 1/4 Sec <u>10</u> Twn <u>5N</u> Rng <u>6E</u>
City State Zip Code	Distance Direction Nearest Town Miles of <u>Lake, MS</u>
Telephone No. <u>387-757-3274</u>	

Well Data

Purpose of Well (circle one) Home Industrial Public Supply Irrigation Fish Culture Other: Rig Supply
Date well drilling started: 1-6-07 Date well drilling completed: 1-8-07
If flowing, method of flow regulation: Valve _____ Other (describe) _____
Static Water Level: 205' feet above or below (circle one) land surface Date measured: 1-9-07
Method of Measurement (circle one) steel tape electric tape air line other: _____
Hole depth: 590' Well depth: 590' Well grouted to a depth of 10 feet
Type of grout (circle one): Cement Bentonite Mix
Casing length: 530 feet Casing diameter: 4 inches Type of casing: PVC
Screen length: 60 feet Screen diameter: 4 inches Type of screen: PVC
Screen slot size: .020 inches Setting depth: From 530 feet to 590 feet
Type of completion (circle all applicable): Gravel packed Underreamed Telescoped Open hole Natural Development
Other (describe): _____
Top of lap pipe or reduction in casing: _____ feet. **If telescoped or more than one screen, describe on back of page**
Logs run (circle all applicable): No log run Electric Gamma Ray Density Sonic Neutron Other: _____
Name of organization running log(s): _____

I certify that the well was drilled, constructed, and completed in accordance with all applicable requirements of the Mississippi Department of Environmental Quality and/or the Mississippi Department of Health regulations and state laws.

RAYBORN DRILLING, INC.

0-60

Print Name of Water Well Contractor and License No.


Signature of Water Well Contractor

RECEIVED
JAN 22 2007
BY: OLWR

N-27

If well telescopes please sketch below and show depths.


Ground Level

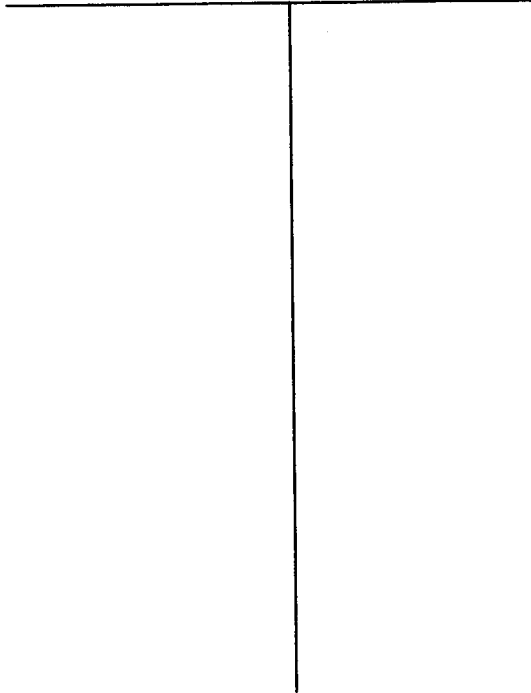

Description of Formations Encountered	From	To
Chalk	0	100
Chalk w/some sand stone	100	280
Blue Chalk	280	400
Chalk w/streaks of sand	400	470
Chalk	470	510
Fine Sand / some streaks	510	550
Good Sand	550	560
Fine Sand	560	590


If more than one screen, show location of each on sketch

Sketch the property layout and include the following: 1) the well location; 2) any permanent structures on the property that may aid in locating the well; 3) any roads, power lines, or other items that may aid in locating the property and the well; 4) indicate direction.

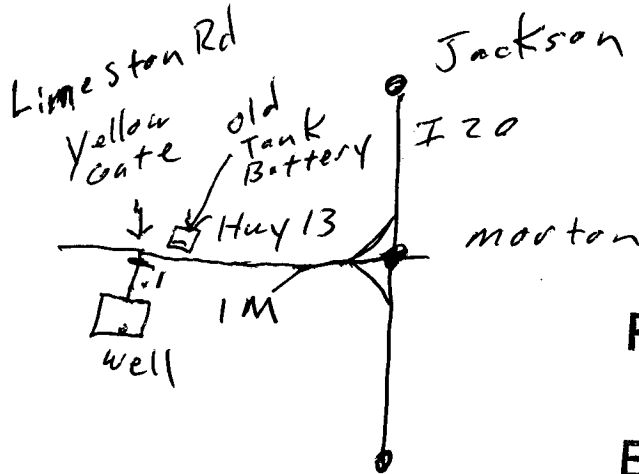

RECEIVED
JAN 22 2007
BY: OLWR

Landowner Name: _____

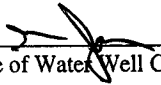

Signature of Water Well Contractor

STATE WELL REPORT

Part 2

Pump Installer's Completion Report
 Mississippi Department of Environmental Quality
 Office of Land and Water Resources
 P.O. Box 10631
 Jackson, MS 39289-0631
 (601)961-5210
 (601)354-6938 (fax)

County: Scott
 Permit #: _____
 Driller: Gary Rayborn
 Date completed: 1-8-07

For Office Use Only:

Aquifer: _____
 Well #: N-27
 Elevation: _____

This report should be prepared by the pump installer in detail and filed with the Department within 30 days of the installation of pump.

Well Owner Information	Well Location
Owner Name: <u>D+D Drilling, Inc</u>	Latitude: _____ Longitude: _____
Mailing Address: <u>P.O. Box 1634</u>	Method of Lat/Long (circle one): Conventional Survey, USGS quad, Hand-held GPS, Survey-grade GPS
<u>Ferriday, LA 71343</u> City State Zip Code	_____ 1/4 _____ 1/4 Sec <u>10</u> Twn <u>5N</u> Rng <u>6E</u>
Telephone No. <u>(318) 757-3274</u>	Distance _____ Direction _____ Nearest Town _____ _____ Miles _____ of <u>Lake, MS</u>

Pump Type Circle one	Power Type Circle one
Air Lift Jet <input type="radio"/> <u>Submersible</u> <input type="radio"/>	Diesel Engine Gasoline Engine Natural Gas
Bucket Piston <input type="radio"/> Turbine <input type="radio"/>	<u>Electric Motor</u> <input type="radio"/> Hand <input type="radio"/> Tractor PTO <input type="radio"/>
Centrifugal Rotary <input type="radio"/> Flowing Well <input type="radio"/>	Windmill Other (specify): _____
Other (specify): _____	Horse Power Rating of Motor: <u>7 1/2 HP</u>
Date Pump Installed: <u>1-9-2007</u>	Setting Depth: <u>273</u> feet
Rated Pump Capacity: <u>60</u> Gallons Per Minute	Number of Stages: <u>14</u>

RECEIVED
 JAN 22 2007
 BY: OLWR

Pump Test Data	Method of Measuring Water Level Circle one
Date Well Tested: _____	Air Line <input type="radio"/> <u>Electric Measuring Line</u> <input type="radio"/> Steel Tape <input type="radio"/>
Static Water Level (A): _____ Feet Below Land Surface	Other (specify): _____
Pumping Water Level (B): _____ Feet Below Land Surface	For flowing well, measured shut in head: _____ feet
Drawdown [(B) - (A)]: _____ Feet Below Land Surface	Well yielded <u>60</u> GPM with a drawdown of _____ feet after _____ hours of pumping
Test Pumping Rate: <u>60</u> Gallons Per Minute	
Duration of Pump Test (minimum 4 hours): _____ hours	

I HEREBY CERTIFY that the above statements are true to the best of my knowledge.

Gary Rayborn 0-60
 Print Name of Pump Installer and License No. (if applicable) Signature of Pump Installer