

SCOTT MISSISSIPPI BOARD OF WATER COMMISSIONERS

01

3

12-28-64

WATER WELL DRILLERS LOG

Date: 12/28, 1964, Driller: Forest Drilling County Scott
 (Name)

| (1) Owner of Land: | Description & Color of Materials Sand, Clay, Red Clay, Shell, etc. | Thick- ness Feet | Depth Feet |
|---|---|------------------------|---------------|
| <u>Gaddis & Gaddis</u> (Name) <u>Forest Drilling</u> (Address) | <u>Red Clay</u> | <u>0</u> | <u>12</u> |
| | <u>Clay + fine sand</u> | | <u>22</u> |
| (2) Location: <u>1/4</u> , <u>1/4</u> , Sec. <u>2</u> : T. <u>10</u> R. <u>10</u> | <u>Blue clay</u> | | <u>262</u> |
| <u>2</u> miles <u>west</u> of <u>Hammond</u> (distance) (direction) (Nearest Town) | <u>Clay + Rock</u> | | <u>292</u> |
| (3) Topography: <u>1</u> (Hilly) (Flat) (Level) | <u>Shale</u> | | <u>352</u> |
| (4) Purpose of Well: <u>Chicken Farm</u> (Domestic Irrigation Municipal, Industrial, Other) | <u>Soft Shale</u> | | <u>422</u> |
| | <u>Shale + Rock</u> | | <u>432</u> |
| | <u>Shale</u> | | <u>457</u> |
| | <u>Fine sand + silt clay</u> | | <u>467</u> |
| | <u>Clay + silt sand</u> | | <u>477</u> |
| | <u>Shale</u> | | <u>504</u> |
| | <u>Fine sand + silt clay</u> | | <u>517</u> |
| | <u>Clay + silt sand</u> | | <u>524</u> |


Information upon completion of well:

- (1) Diameter 2 inches.
- (2) Total Depth 519 feet.
- (3) Water Level 105 feet below top of ground.
- (4) Cased to 504, Size 2"
- (5) Screen: Size 2", Length 15 ft
- (6) Were any formations sealed against pollution?
 yes, no.

If YES depth of formation _____

Why _____

Drillers Remarks: _____

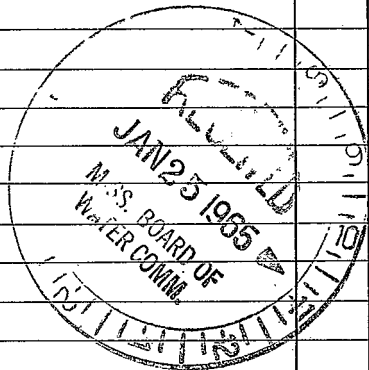

(Use Back Side)

Well No.

